IREDELL COUNTY HEALTH DEPARTMENT

STATESVILLE 704-878-5305 MOORESVILLE 704-664-5281

IMPROVEMENT PERMIT / AUTHORIZATION TO CONSTRUCT / OPERATION PERMIT / EXISTING SYSTEM INSPECTION

PERMIT# 094016 PIN# 4735 39 1997 DATE 2-3-01

OWNER OR CONTRACTOR RANDY SPARKS PHONE: Business Home 873-3673

ADDRESS 819 KENTWOOD DR. STATESVILLE, NC 28677

LOCATION NC 115 NORTH, TR UPPER OAK DR, TL GOLDEN OAK, LOT AT END ON RIGHT

SUBDIVISION MEADOW OAKS BLOCK / SECTION II LOT 72 LOT AREA 1.164 ACRE SITE CLASS PS DESIGN FLOW 480 L.T.A.R. 0.3 GPD/FT²

Septic Tank: 1000 Gallons: STB 1007 Date 12-28-00
Pump Tank: 1000 Gallons: PT 274 Date 11-21-00
Pump Make: HYDRAMATIC Model SIGEOAT Serial No.
Nitrification Field: No Fields 1 Square Feet 1600 Linear Feet 533
No Lines FIVE Trench Width 36" Max Trench Bottom Depth 36" Gravel Depth 12"

☑ New System ☐ Repair System Type: I. II. III. IV. V. VI
System Description: CONVENTIONAL PUMP-PER
Repair System Description: CONV. PUMP-PER
Maintenance Agreement Required: ☐ Yes ☑ No
☐ Slab ☑ Crawl Space ☐ Basement w/plumbing ☐ Basement wo/plumbing


☑ House/Mod. Home No. Bedrooms 3
☐ Mobile Home No. Bathrooms 5
☐ Business No. Employees
☐ Other UNFINISHED BASEMENT

Water Supply: ☐ Individual ☑ Public ☐ Community

Comments/Conditions: SEE ATTACHED SHEETS FOR PUMP AND PRESSURE MANIFOLD REQUIREMENTS

Comments/Conditions: DRAINLINES INSPECTED 3-6-01 (RSH) TANKS CHANGED AS SHOWN WITH PRIOR HEALTH DEPT. APPROVAL.

INITIAL SITE SKETCH

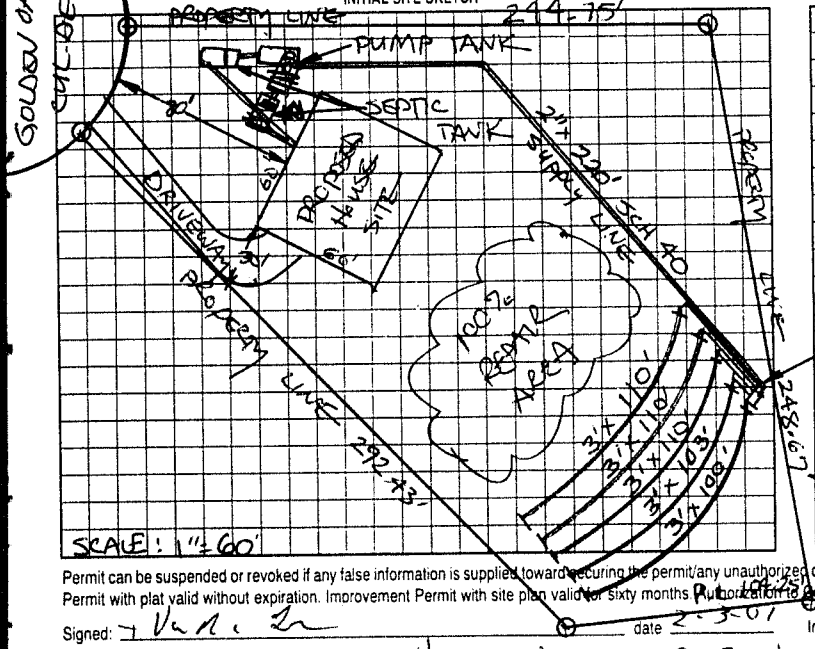

AS BUILT SKETCH

SYSTEM INSTALLED ACCORDING TO INITIAL SITE SKETCH

PRESSURE MANIFOLD

Permit can be suspended or revoked if any false information is supplied toward securing the permit/any unauthorized changes are made to the site/any unauthorized changes are made in the installation of the system. Improvement Permit with plat valid without expiration. Improvement Permit with site plan valid for sixty months. Authorization to Construct is valid for a period equal to that of Improvement Permit – not to exceed sixty months.

Signed: [signature] date 2-3-01

Improvement Permit by: STEVE HEDRICK date 2-3-01

Authorization to Construct by: STEVE HEDRICK date 2-3-01

Installed by: JAMES ADLER

Operation Permit by: STEVE HEDRICK date 8-13-01

Existing System Inspection by: date

HEALTH DEPT COPY WHITE OWNER COPY (FINAL) YELLOW OWNER COPY (INITIAL) PINK