IREDELL COUNTY HEALTH DEPARTMENT

STATESVILLE 704-878-5305 MOORESVILLE 704-664-5281

IMPROVEMENT PERMIT / AUTHORIZATION TO CONSTRUCT / OPERATION PERMIT / EXISTING SYSTEM INSPECTION

PERMIT# 094186 PIN# 4735 39 2384 DATE 2-3-01

OWNER OR CONTRACTOR KENT SHAW PHONE: Business Home 528-6805

ADDRESS P.O. Box 1061 TROUTMAN NC 28166

LOCATION NC 115 North, TR UPPER OAK DR LOT on LEFT ACROSS from CANOPY OAK DR.

SUBDIVISION MEADOW OAKS BLOCK / SECTION II LOT 88 LOT AREA 0.582 Acre SITE CLASS PS DESIGN FLOW 480 L.T.A.R. 0.35 GAD/FT²

Septic Tank: 1000 Gallons; STB 1007 Date 5-21-01
Pump Tank: Gallons; PT Date
Pump Make: Model Serial No.
Nitrification Field: No Fields 1 Square Feet Eq. to 1680 Linear Feet 345+
No Lines SIX Trench Width 36" Max Trench Bottom Depth 36" Gravel Depth N/A


☑ New System ☐ Repair System Type: I. II. III. IV. V. VI
System Description: 25% REDUCTION GRAVITY
Repair System Description: 50% REDUCTION, PUMP
Maintenance Agreement Required: ☐ Yes ☑ No

☑ House/Mod. Home No. Bedrooms 4
☐ Mobile Home No. Bathrooms 2½
☐ Business No. Employees
☐ Other
☐ Slab ☑ Crawl Space ☐ Basement w/plumbing ☐ Basement wo/plumbing

Water Supply: ☐ Individual ☑ Public ☐ Community


Comments:/Conditions: INSTALL 25% REDUCTION SYSTEM USING 57 CHAMBERS OR 35 HDS SECTIONS ON CONTOUR AS FLAGGED ② STUB-OUT PLUMBING HIGH TO ACCOMODATE SHALLOW TANK PLACEMENT

INITIAL SITE SKETCH

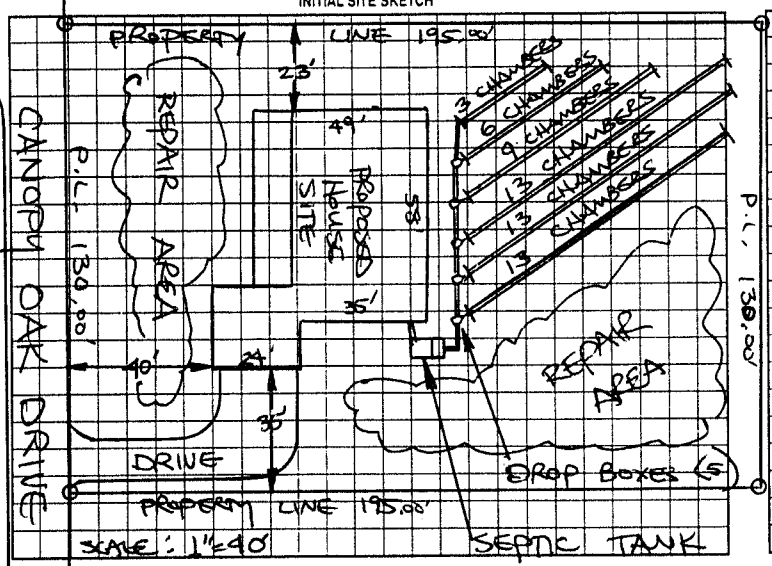

Comments:/Conditions:
Polylok Filter Installed
- Septic Tank Risers Installed
-52 Infiltrator Chambers Installed

AS BUILT SKETCH

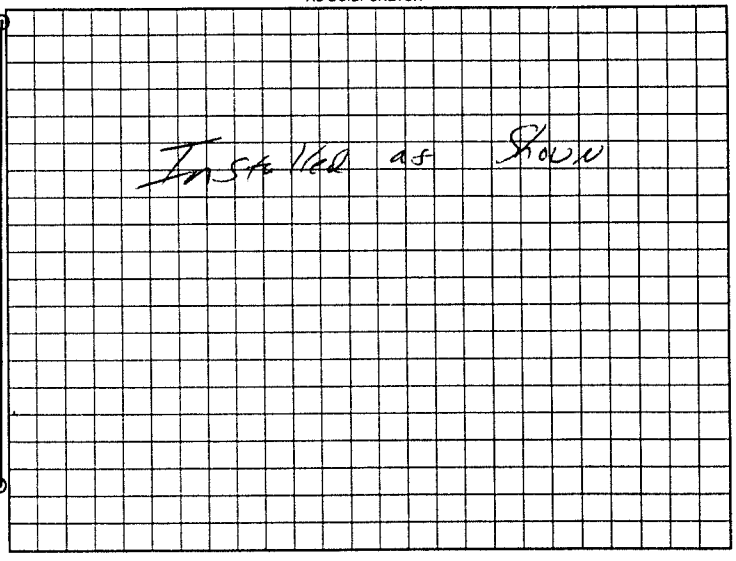

Permit can be suspended or revoked if any false information is supplied toward securing the permit/any unauthorized changes are made to the site/any unauthorized changes are made in the installation of the system. Improvement Permit with plat valid without expiration. Improvement Permit with site plan valid for sixty months. Authorization to Construct is valid for a period equal to that of Improvement Permit – not to exceed sixty months.

Signed: [signature] date 2-5-01 Installed by: James Hubler

Improvement Permit by: STEVE HEDRICK date 2-3-01 Operation Permit by: William O. Johnson date 8/14/01

Authorization to Construct by: STEVE HEDRICK date 2-3-01 Existing System Inspection by: date

HEALTH DEPT. COPY: WHITE OWNER COPY (FINAL): YELLOW OWNER COPY (INITIAL): PINK