IREDELL COUNTY HEALTH DEPARTMENT

STATESVILLE 704-878-5305 MOORESVILLE 704-664-5281

IMPROVEMENT PERMIT / AUTHORIZATION TO CONSTRUCT / OPERATION PERMIT / EXISTING SYSTEM INSPECTION

PERMIT# 088921 PIN# 4735 39 4157 (PT) DATE 5-6-00

OWNER OR CONTRACTOR JEFFREY TAYLOR PHONE: Business Home 876-2223

ADDRESS 112 CULPEPPER ROAD, STATESVILLE NC 28625

LOCATION NC 115 NORTH, TR UPPER OAK DR, TL GOLDEN OAK ROAD, PS, LOT AT END ON RIGHT

SUBDIVISION MEADOW OAKS BLOCK / SECTION II LOT 73 LOT AREA 0.932 ACRE SITE CLASS PS DESIGN FLOW 480 L.T.A.R. 0.30 GAD/FT²

Septic Tank: 1000 Gallons: STB 1012 Date 11-4-2000
Pump Tank: 1000 Gallons: PT 1012 Date 9-25-2000
Pump Make: GOULDS Model WE0511M Serial No. 00173571
Nitrification Field: No Fields 1 Square Feet 1600 Linear Feet 540
No Lines SIX Trench Width 36" Max Trench Bottom Depth 36" Gravel Depth 12"

☒ New System ☐ Repair System Type: I, II, (III), IV, V, VI
System Description: CONVENTIONAL PUMP
Repair System Description: 50% REDUCTION, LPP
Maintenance Agreement Required: ☐ Yes ☒ No

☒ House/Mod. Home No. Bedrooms 4
☐ Mobile Home No. Bathrooms 2½
☐ Business No. Employees
☐ Other


☐ Slab ☒ Crawl Space ☐ Basement w/plumbing ☐ Basement wo/plumbing

Water Supply: ☐ Individual ☒ Public ☐ Community


Comments:/Conditions: ① SCOUR TRENCH SIDEWALLS WHERE SMEARING OCCURS ② SEE ATTACHED SHEETS FOR PUMP & PRESSURE MANIFOLD REQUIREMENTS.

Comments:/Conditions ① INSTALLED USING POLYLOK FILTER

INITIAL SITE SKETCH

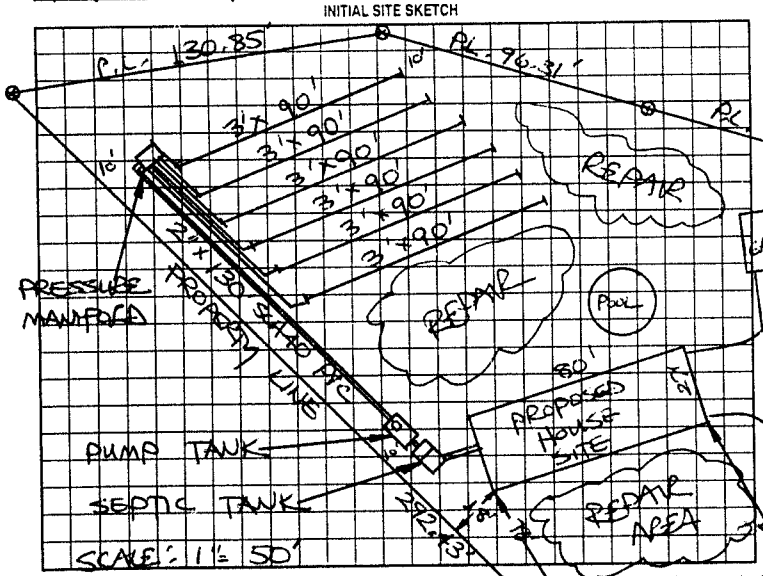

AS BUILT SKETCH

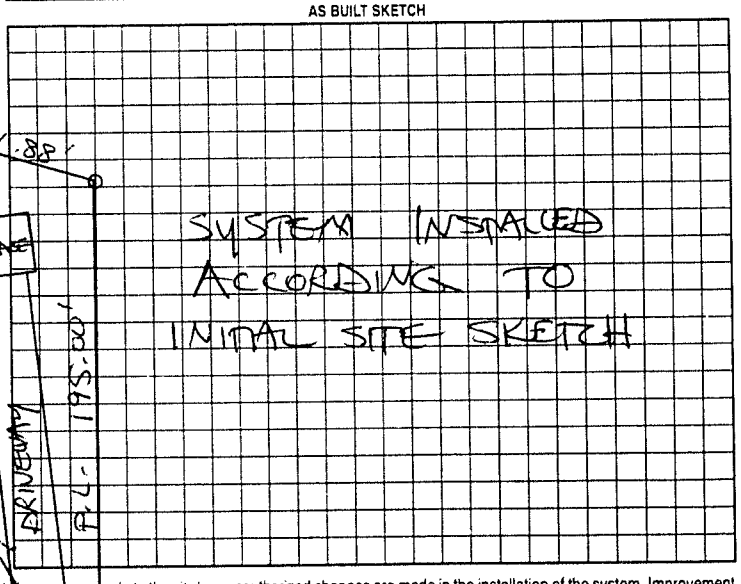

Permit can be suspended or revoked if any false information is supplied toward securing the permit/any unauthorized changes are made to the site/any unauthorized changes are made in the installation of the system. Improvement Permit with plat valid without expiration. Improvement Permit with site plan valid for sixty months. Authorization to Construct is valid for a period equal to that of Improvement Permit – not to exceed sixty months.

Signed: Glenda Taylor date 5-12-00 Installed by: STEVE [redacted] JORDAN

Improvement Permit by: STEVE HEDRICK date 5-6-00 Operation Permit by: STEVE HEDRICK date 4-6-01

Authorization to Construct by: STEVE HEDRICK date 5-6-00 Existing System Inspection by: date

HEALTH DEPT. COPY. WHITE OWNER COPY (FINAL) YELLOW OWNER COPY (INITIAL) PINK