IREDELL COUNTY HEALTH DEPARTMENT

STATESVILLE 704-878-5305 (C) MOORESVILLE 704-664-5281

IMPROVEMENT PERMIT / AUTHORIZATION TO CONSTRUCT / OPERATION PERMIT / EXISTING SYSTEM INSPECTION

(C)

PERMIT# 120909 PIN# 4935-39-3613 DATE 7/14/04

OWNER OR CONTRACTOR Ronald E. Broome PHONE: Business - Home (704) 902-2057

ADDRESS P.O. Box 248 Troutman, N.C. 28166

LOCATION Hwy 21 N @ Fort Dobbs, @ Chipley Ford, @ on Canup, Oak @ Upper Oak Drive to End on Left @ Cul-de-Sac.

SUBDIVISION Meadow Oaks BLOCK / SECTION II LOT 90 LOT AREA .54 Ac SITE CLASS. PS DESIGN FLOW 360 L.T.A.R. .30

Septic Tank: 4000 Gallons; STB 1012 Date 6-22-04
Pump Tank: _____ Gallons; PT _____ Date _____
Pump Make: _____ Model _____ Serial No. _____
Nitrification Field: No Fields 1 Square Feet Eq to 1200 Linear Feet 300
No Lines 6 (5'x) Trench Width 36 Max Trench Bottom Depth 30" Gravel Depth NA

☒ New System ☐ Repair System Type: I, II, (III) IV, V, VI
System Description: Gravity, 25% Red
Repair System Description: Pump, 50% Reduction
Maintenance Agreement Required: ☐ Yes ☒ No

☒ House/Mod. Home No. Bedrooms 3
☐ Mobile Home No. Bathrooms ____
☐ Business No. Employees ____
☐ Other ____


☐ Slab ☒ Crawl Space ☐ Basement w/plumbing ☐ Basement wo/plumbing

Water Supply: ☒ Individual ☒ Public ☐ Community

Comments:/Conditions: (1) Install lines on contour (2) maintain proper setbacks

Comments:/Conditions: SEPTIC TANK WITH MARKER INSTALLED ACCORDING TO INITAL SITE SKETCH USING "ULTRAFINE" FILTER

INITIAL SITE SKETCH 1"=60Ft

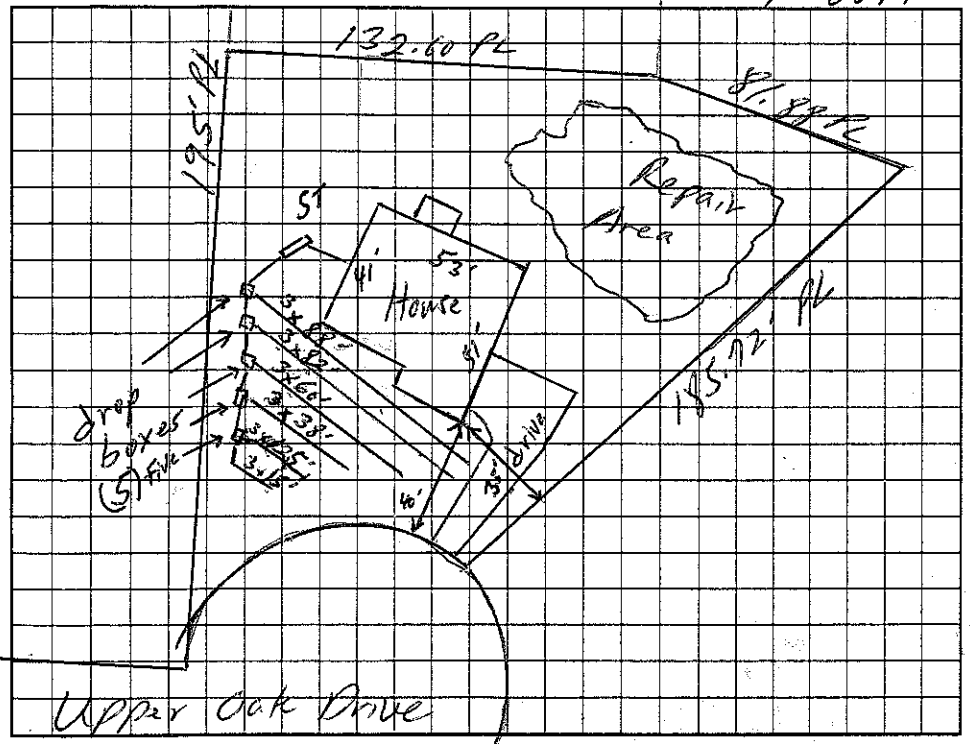

AS BUILT SKETCH

AS SHOWN

Permit can be suspended or revoked if any false information is supplied toward securing the permit/any unauthorized changes are made to the site/any unauthorized changes are made in the installation of the system. Improvement Permit with plat valid without expiration. Improvement Permit with site plan valid for sixty months. Authorization to Construct is valid for a period equal to that of Improvement Permit – not to exceed sixty months.

Signed: Ronald E. Broome date 7/14/04

Improvement Permit by: William O. Johnson date 7/14/04

Authorization to Construct by: William O. Johnson date 7/14/04

Installed by: TOMMY FRYE

Operation Permit by: STEVE HEDRICK date 10-22-04

Existing System Inspection by: _____ date _____

HEALTH DEPT. COPY: WHITE OWNER COPY (FINAL): YELLOW OWNER COPY (INITIAL): PINK