IREDELL COUNTY HEALTH DEPARTMENT

STATESVILLE 704-878-5305 MOORESVILLE 704-664-5281

IMPROVEMENT PERMIT / AUTHORIZATION TO CONSTRUCT / OPERATION PERMIT / EXISTING SYSTEM INSPECTION

PERMIT# 086645 PIN# 4735 39 4157 (PT) DATE 12-13-99

OWNER OR CONTRACTOR EARNHARDT, GEORGE, ETC PHONE: Business 871-0745 Home

ADDRESS 425 OAKHURST DRIVE, STATESVILLE, NC 28687

LOCATION NC 115 North, TR UPPER OAK DRIVE, LOT ON RIGHT AT CANOPY OAK LANE

SUBDIVISION MEADOW OAKS BLOCK / SECTION II LOT 112 LOT AREA 0.927 ACRE SITE CLASS PS DESIGN FLOW 360 L.T.A.R. 0.30 GPD/FT²

Septic Tank: 1000 Gallons; STB 312 Date 10-29-00
Pump Tank: 1000 Gallons; PT 283 Date 4-6-00
Pump Make: Hydromatic Model Shet 50 AI Serial No.
Nitrification Field: No Fields 1 Square Feet EQ. TO 1200 Linear Feet 300+
No Lines FIVE Trench Width 36" Max Trench Bottom Depth 36" Gravel Depth 6" SAND

☑ New System ☐ Repair System Type: I, II, (III), IV, V, VI
System Description: 25% REDUCTION, PUMP
Repair System Description: 50% REDUCTION, LOW PRES.
Maintenance Agreement Required: ☐ Yes ☑ No


☑ House/Mod. Home No. Bedrooms 3
☐ Mobile Home No. Bathrooms 3
☐ Business No. Employees
☐ Other
☐ Slab ☐ Crawl Space ☑ Basement w/plumbing ☐ Basement wo/plumbing

Water Supply: ☐ Individual ☑ Public ☐ Community

Comments/Conditions: ① INSTALL 25% REDUCTION SYSTEM USING 50 CHAMBERS OR 30 HDS SECTIONS ON CONTOUR AS PLACED ② SEE ATTACHED SHEETS FOR PUMP & PRESSURE MANIFOLD REQUIREMENTS

Comments/Conditions: 6-9-00 Lines & Trenches installed as shown
6-27 Alarm & Mixing LK
Pressure set

INITIAL SITE SKETCH

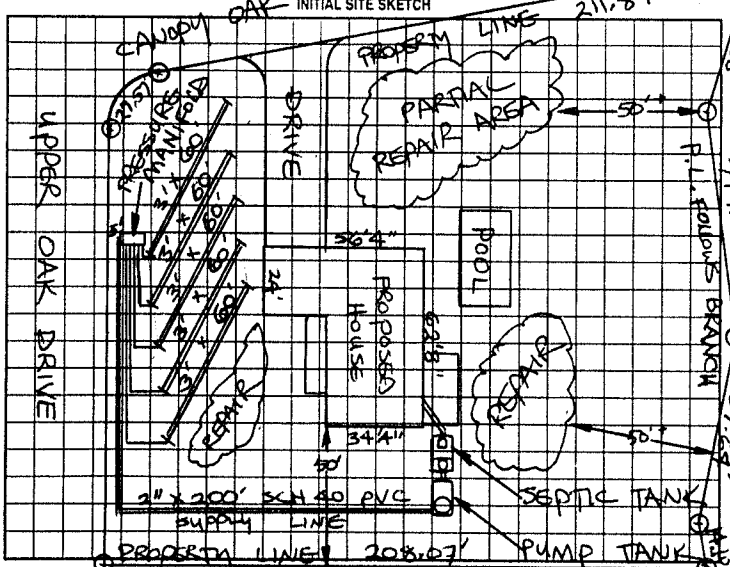

AS BUILT SKETCH

System Install As Shown
Using HDS Section

Permit can be suspended or revoked if any false information is supplied toward securing the permit/any unauthorized changes are made to the site/any unauthorized changes are made in the installation of the system. Improvement Permit with plat valid without expiration. Improvement Permit with site plan valid for sixty months. Authorization to Construct is valid for a period equal to that of Improvement Permit – not to exceed sixty months.

Signed: Jo Ann Earnhardt date 12-16-99

Improvement Permit by: STEVE HEDRICK date 12-13-99

Authorization to Construct by: STEVE HEDRICK date 12-13-99

Installed by: Craig Thompson

Operation Permit by: J. C. Potter date June 27 2000

Existing System Inspection by: date

HEALTH DEPT. COPY WHITE OWNER COPY (FINAL) YELLOW OWNER COPY (INITIAL) PINK