IREDELL COUNTY HEALTH DEPARTMENT

STATESVILLE 704-878-5305 MOORESVILLE 704-664-5281

CI

IMPROVEMENT PERMIT / AUTHORIZATION TO CONSTRUCT / OPERATION PERMIT / EXISTING SYSTEM INSPECTION

PERMIT# 13448 6 PIN# 4735395604 DATE 4-3-06

OWNER OR APPLICANT Randy Wilson PHONE: Business 704 880 8219 Home

ADDRESS 186 Upper Oak Drive

LOCATION I-40 W to exit 150 N on Hwy 115 2 miles, turn right on Upper Oak Dr. property on R at end

SUBDIVISION Meadow Oaks II BLOCK / SECTION LOT 92 LOT AREA .92 SITE CLASS. PS DESIGN FLOW 360 L.T.A.R. .25

Septic Tank: 1000 Gallons: STB 1012 Date

Pump Tank: Gallons: PT Date

Pump Make: Model Serial No.

Nitrification Field: No Fields 1 Square Feet 1440 Linear Feet 10 360

No Lines 5 Trench Width 36" Max Trench Bottom Depth 36" Gravel Depth N/A ☒ Gravity ☐ Pressure

☒ New System ☐ Repair ☐ Expansion System Type: I (II) III IV V VI

System Description: 25% Reduction

Repair System Description: LP Reduction 30%

Maintenance Agreement Required: ☐ Yes ☒ No

☒ House/Mod. Home ☐ Mobile Home ☐ Business ☐ Other

No. Bedrooms 3 No. Persons No. Employees


Water Supply: ☐ Individual ☒ Public ☐ Community

☐ Slab ☒ Crawl Space ☐ Basement w/plumbing ☐ Basement wo/plumbing


Comments:/Conditions:

Comments:/Conditions:

INITIAL SITE SKETCH

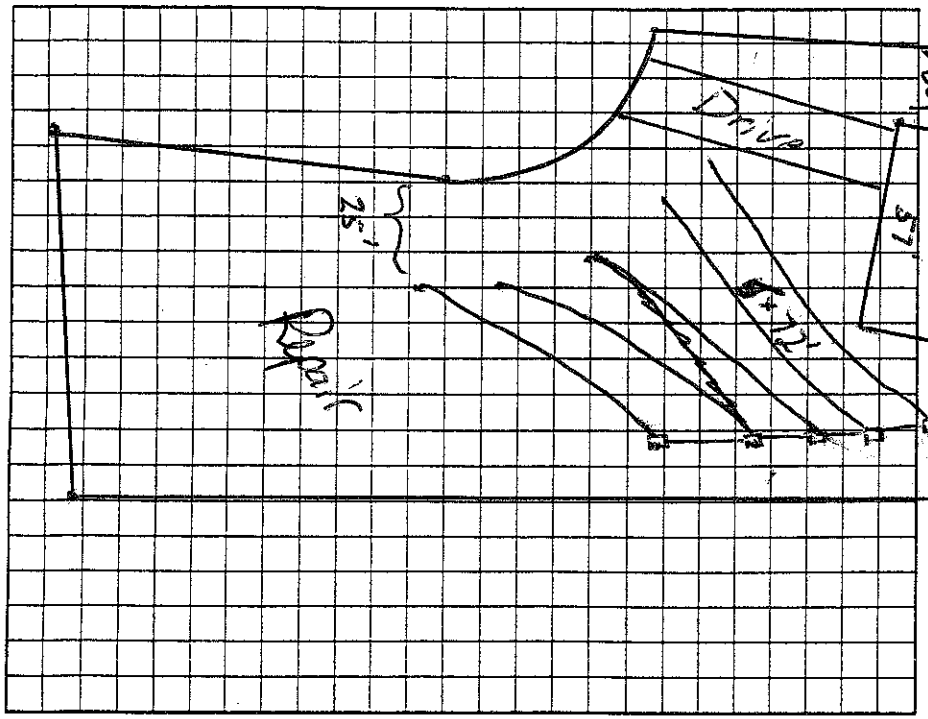

AS BUILT SKETCH

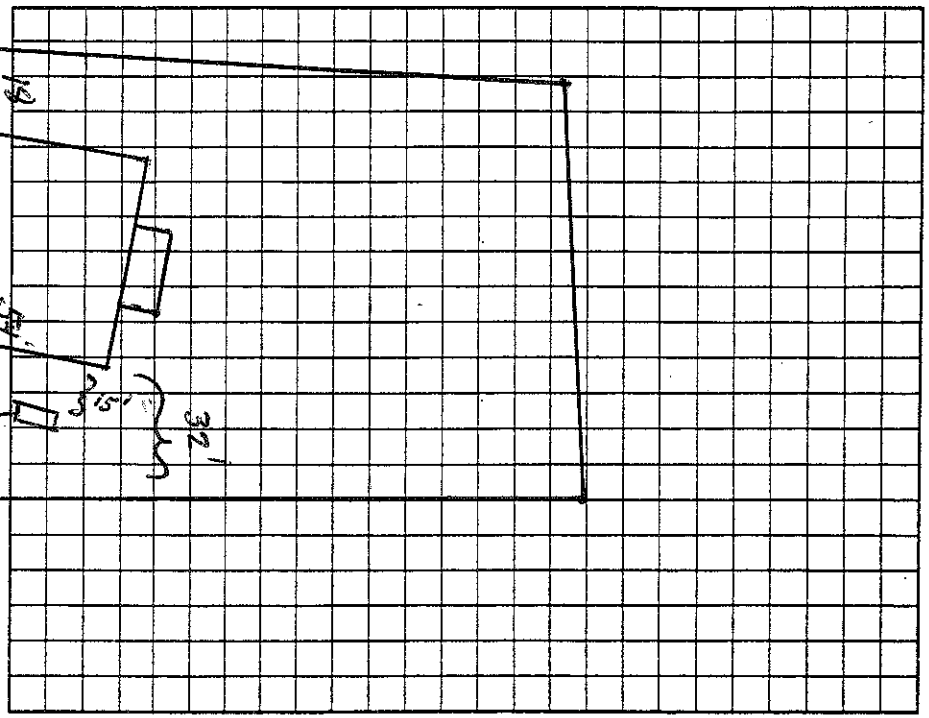

Permit can be suspended or revoked if any false information is supplied toward securing the permit/any unauthorized changes are made to the site/any unauthorized changes are made in the installation of the system. Improvement Permit with plat valid without expiration ☐ Improvement Permit with site plan valid for sixty months ☐ Authorization to Construct is valid for a period equal to that of Improvement Permit – not to exceed sixty months.

Signed: Randy Wilson date 4-19-06 Installed by: Steve Jordan

Improvement Permit by: James Brewer date 4-3-06 Operation Permit by: James Brewer date 11/30/06

Authorization to Construct by: James Brewer date 4-3-06 Existing System Inspection by: date

HEALTH DEPT. COPY: WHITE OWNER COPY (FINAL): YELLOW OWNER COPY (INITIAL): PINK