# IREDELL COUNTY HEALTH DEPARTMENT

STATESVILLE 704-878-5305 MOORESVILLE 704-664-5281

## IMPROVEMENT PERMIT / AUTHORIZATION TO CONSTRUCT / OPERATION PERMIT / EXISTING SYSTEM INSPECTION

PERMIT# 133354 PIN# 5735397559 DATE 4-25-07

OWNER OR APPLICANT Matt Mayer PHONE: Business 704-902-7017 Home

ADDRESS 2620 East Broad Street NC 28625

LOCATION Cooper Ford Rd (R) Sullivan Farm (R) Meadow Farm (R) Meadow Oaks

SUBDIVISION Meadow Oaks BLOCK / SECTION LOT 14 LOT AREA 1.08 SITE CLASS. DESIGN FLOW L.T.A.R. 12

Septic Tank: 1000 Gallons; STB 1012 Date 10-2-06

Pump Tank: Gallons; PT Date

Pump Make: Model Serial No.

Nitrification Field: No Fields Square Feet 1600 Linear Feet 480

No Lines 6 Trench Width 24" 36" Max Trench Bottom Depth 36" Gravel Depth ☐ Gravity ☐ Pressure

☐ New System ☐ Repair ☐ Expansion System Type: I II III IV V VI

System Description: 25% Expansion

Repair System Description: 50% Less Flow

Maintenance Agreement Required: ☐ Yes ☐ No

☐ House/Mod. Home ☐ Mobile Home ☐ Business ☐ Other


No. Bedrooms 3 No. Persons No. Employees

Water Supply: ☐ Individual ☑ Public ☐ Community

☐ Slab ☐ Crawl Space ☐ Basement w/plumbing ☑ Basement wo/plumbing

Comments/Conditions: Drainage Ditch

INITIAL SITE SKETCH

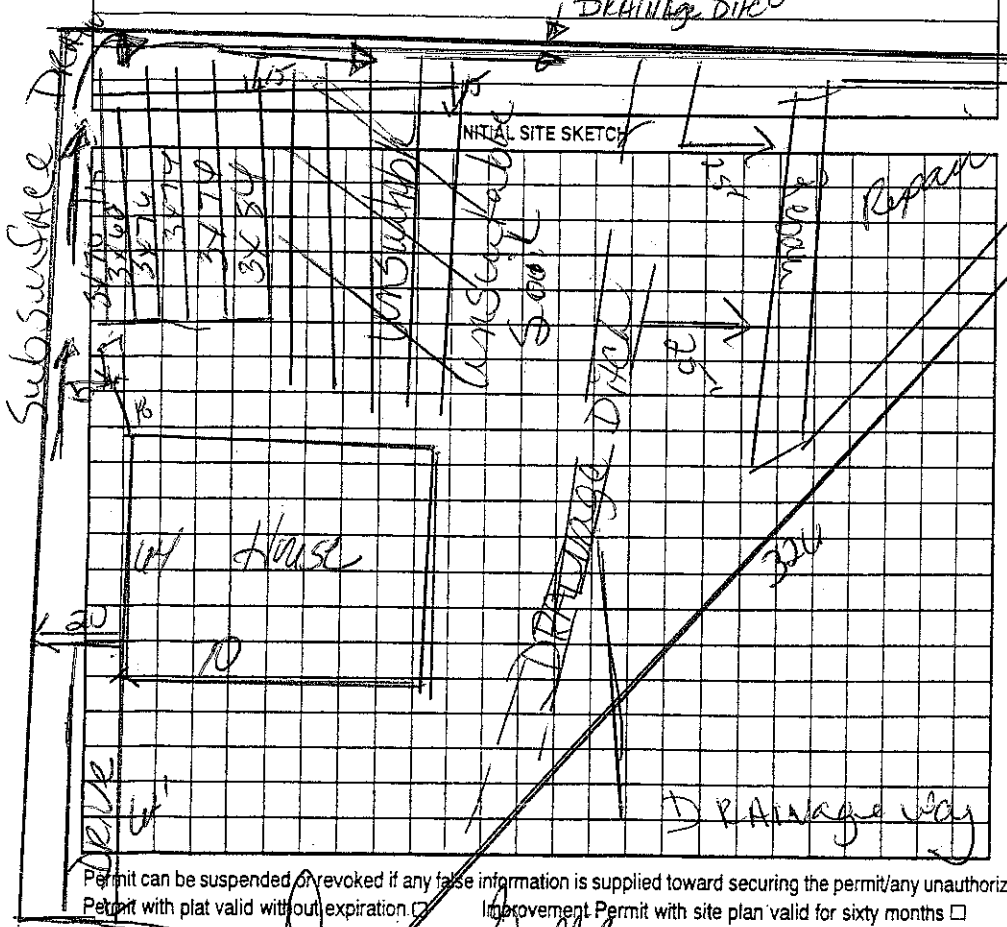


Comments/Conditions: Install on contour Maintain all setbacks Yellow tape this

AS BUILT SKETCH

Septic tank marker

Endcap distribution

maintained 15' of drainage ditch

15' of Bottom Soil to or Chroma 1/2 for 15' the Soil was 2 and 10 mottling

Permit can be suspended or revoked if any false information is supplied toward securing the permit/any unauthorized changes are made to the site/any unauthorized changes are made in the installation of the system. Improvement Permit with plat valid without expiration ☐ Improvement Permit with site plan valid for sixty months ☐ Authorization to Construct is valid for a period equal to that of Improvement Permit – not to exceed sixty months.

Signed: Dennis Ballew date

Improvement Permit by: Kelly Cox date 4-25-07

Authorization to Construct by: Kelly Cox date 4-25-07

Installed by: A-1 Backhoe

Operation Permit by: Kelly Cox date 4-25-07

Existing System Inspection by: date

HEALTH DEPT. COPY: WHITE OWNER COPY (FINAL): YELLOW OWNER COPY (INITIAL): PINK