IREDELL COUNTY HEALTH DEPARTMENT

STATESVILLE 704-878-5305 MOORESVILLE 704-664-5281

IMPROVEMENT PERMIT / AUTHORIZATION TO CONSTRUCT / OPERATION PERMIT / EXISTING SYSTEM INSPECTION

PERMIT# 094091 PIN# 4735 39 8017 DATE 2-3-01

OWNER OR CONTRACTOR WAYNE HOMES PHONE: Business (704) 229-7342 Home (704) 506-2481

ADDRESS 139 SAND REED DR, MOORESVILLE, NC 28117

LOCATION NC 115 N TR S. CHAPLEY FORD, TL CANOPY OAK DR, 3RD LOT ON LEFT BEFORE UPPER OAK DR

SUBDIVISION MEADOW OAKS BLOCK / SECTION II LOT 110 LOT AREA 0.774 ACRE SITE CLASS. PS DESIGN FLOW 480 L.T.A.R. 0.25 GPD/FT²

Septic Tank: 1000 Gallons: STB 372 Date 10-11-99
Pump Tank: _____ Gallons; PT _____ Date _____
Pump Make: _____ Model _____ Serial No. _____
Nitrification Field: No Fields 1 Square Feet Eq. to 1920 Linear Feet 480+
No Lines FIVE Trench Width 36" Max Trench Bottom Depth 36" Gravel Depth N/A

☑ New System ☐ Repair System Type: I, II, (III), IV, V, VI
System Description: 25% REDUCTION GRAVITY
Repair System Description: 50% REDUCTION, PUMP
Maintenance Agreement Required: ☐ Yes ☑ No


☑ House/Mod Home No. Bedrooms 4
☐ Mobile Home No. Bathrooms 2 ½
☐ Business No. Employees _____
☐ Other _____
☐ Slab ☑ Crawl Space ☐ Basement w/plumbing ☐ Basement wo/plumbing

Water Supply: ☐ Individual ☒ Public ☐ Community


Comments/Conditions: INSTALL 25% REDUCTION SYSTEM USING EIGHTY (80) CHAMBERS OR FORTY-EIGHT (48) HDS SECTIONS ON CONTOUR AS FLAGGED

Comments/Conditions:
- Installed 80 chambers
- ✓ Label filter
- ✓ Septic Tank marker

INITIAL SITE SKETCH

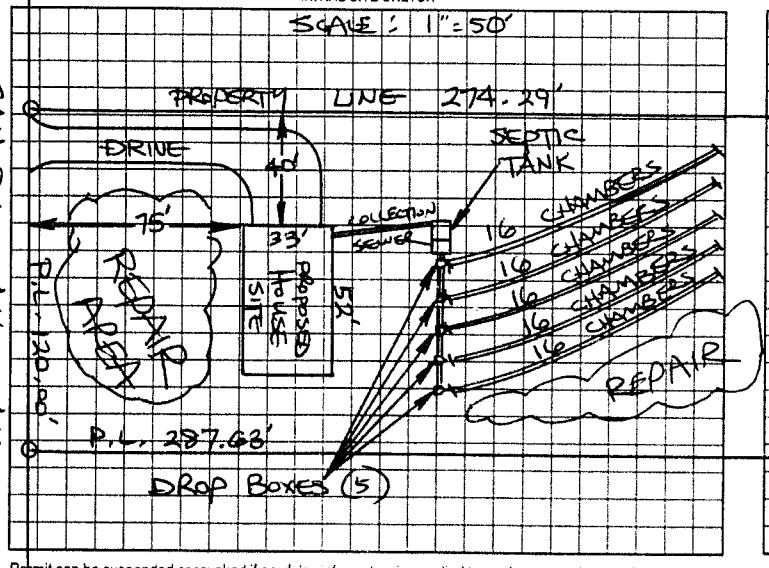

AS BUILT SKETCH

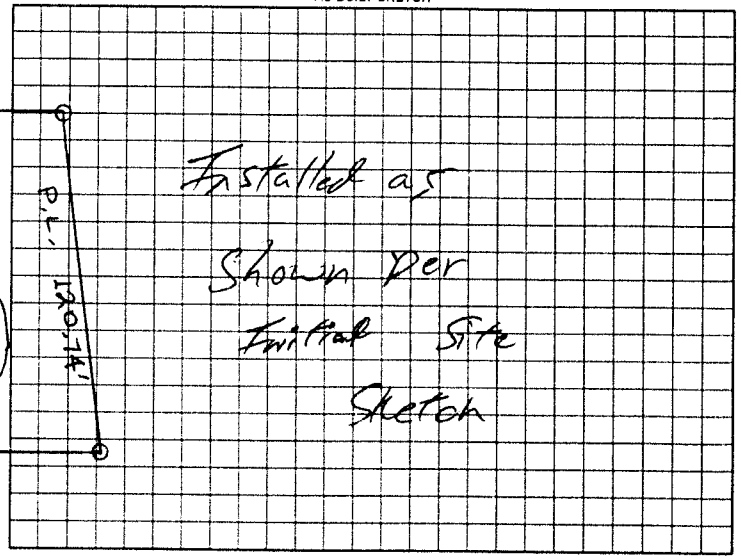

Permit can be suspended or revoked if any false information is supplied toward securing the permit; any unauthorized changes are made to the site; any unauthorized changes are made in the installation of the system. Improvement Permit with plat valid without expiration. Improvement Permit with site plan valid for sixty months. Authorization to Construct is valid for a period equal to that of Improvement Permit – not to exceed sixty months.

Signed: William Johnson date 2-8-01 Installed by: Mitchell Hauling & Grading Co.

Improvement Permit by: STEVE HEDRICK date 2-3-01 Operation Permit by: William E. Johnson date 6/14/01

Authorization to Construct by: STEVE HEDRICK date 2-3-01 Existing System Inspection by: _____ date _____

HEALTH DEPT COPY WHITE OWNER COPY (FINAL) YELLOW OWNER COPY (INITIAL) PINK