IREDELL COUNTY HEALTH DEPARTMENT

Statesville Phone TR 3-7271 Mooresville Phone NO 3-1271

PERMIT TO INSTALL SEPTIC TANK

Permit NO. _____ Permit Date Oct 4 19 67

Owner Deerhorn Bldg Co. Address R1

Installed By C Hoke Address R7


Location of Property Starmount # 8 - on left on hill

Tank		Capacity		Length of Lines		Fixtures	
Block	( )	1000	( )	225'	( )	No. of Baths	(2)
Precast	(✓)	1250	( )	250'	( )	Dishwasher	(--)
Hook		1500	(✓)	Other 255'		Garbage Grdr.	(--)
		Other _____				Other _____	

NOTIFY HEALTH DEPARTMENT AT LEAST EIGHT HOURS BEFORE TANK IS TO BE INSPECTED.

Final Inspection _____ 19__ Approved ( ) Disapproved ( )

Remarks City Water - tank very deep due to plumbing rough out.

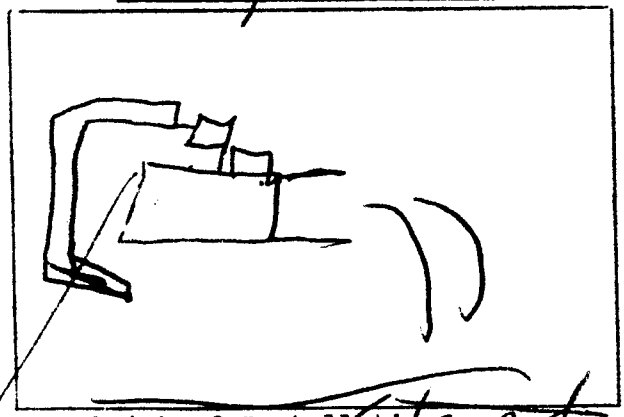

Sketch of Installation Street

Sanitarian