IREDELL COUNTY HEALTH DEPARTMENT

Statesville Phone TR 3-7271 Mooresville Phone NO 3-1271

PERMIT TO INSTALL SEPTIC TANK

Permit NO. _____ Permit Date _____ 19___

Owner Townhouse Building Address Statesville, N.C.

Installed By Clyde Clark Address Statesville, N.C.


Location of Property Hwy 115 N. Left Starmount Sub. Division, Left Gregory Rd. Lane across from dead End Rd

Tank		Capacity		Length of Lines		Fixtures	
Block	( )	1000	(✓)	225'	(✓)	No. of Baths	( )
Precast	( )	1250	( )	250'	( )	Dishwasher	( )
		1500	( )	Other _____		Garbage Grdr.	( )
		Other _____				Other _____	

NOTIFY HEALTH DEPARTMENT AT LEAST EIGHT HOURS BEFORE TANK IS TO BE INSPECTED.

Final Inspection 7-27 1966 Approved (✓) Disapproved ( )

Remarks _____

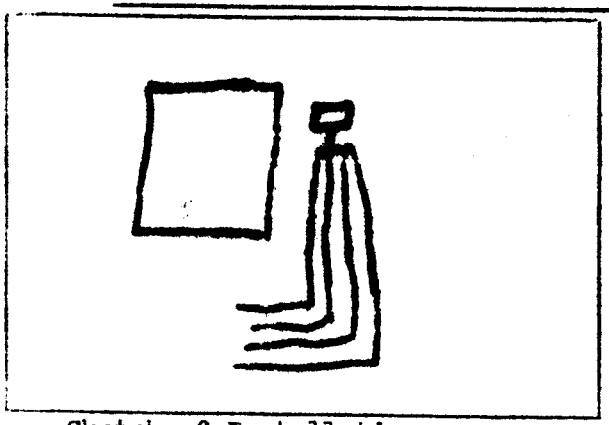

Sketch of Installation

Sanitarian