IREDELL COUNTY HEALTH DEPARTMENT

Statesville Phone TR 3-7271 Mooresville Phone NO 3-1271

PERMIT TO INSTALL SEPTIC TANK

Permit NO. _____ Permit Date Nov 17 1967

Owner Earl Carney Address c/o WDBM Radio Sta.

Installed By C Hoke Address R 7

Location of Property Statesville S/D off 115 N


1st on Rt cross back

Tank	Capacity	Length of Lines	Fixtures
Block ( )	1000 ( )	225' ( )	No. of Baths (3)
Precast (✓)	1250 (✓)	250' ( )	Dishwasher (✓)
	1500 ( )	Other 270'	Garbage Grdr. (✓)
soak pit	Other _____		Other _____

NOTIFY HEALTH DEPARTMENT AT LEAST EIGHT HOURS BEFORE TANK IS TO BE INSPECTED.

Final Inspection _____ 19___ Approved ( ) Disapproved ( )

Remarks Wooded - Steep - Very deep - due to plumbing city water - Not to be held liable for any damage due to grading or yard work.

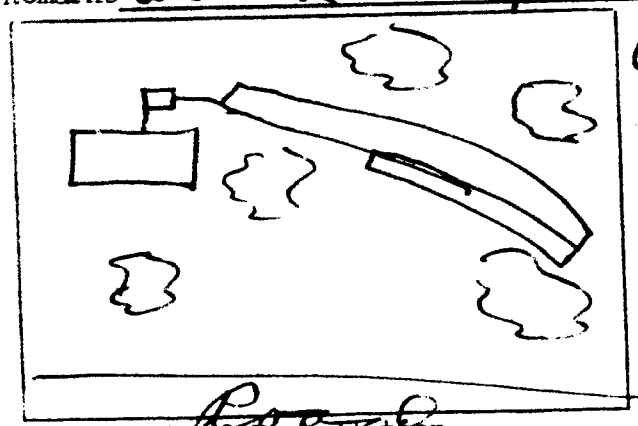

Sketch of Installation

Sanitarian