IREDELL COUNTY HEALTH DEPARTMENT

Statesville Phone TR 3-7271 Mooresville Phone NO 3-1271

PERMIT TO INSTALL SEPTIC TANK

Permit No. 296 Permit Date 4-13 1968

Owner Iredell Oil Co. Address Statesville, N.C.

Installed By T.W. Hyatt Address 1203 Wyatt Road Statesville, N.C.


Location of Property Hwy 115 N Corner Lot State 40 second building on Rt

Tank		Capacity		Length of Lines		Fixtures	
Block	( )	1000	(✓)	225'	( )	No. of Baths	( )
Precast	( )	1250	( )	250'	( )	Dishwasher	( )
		1500	( )	Other		Garbage Grdr.	( )
		Other				Other	

NOTIFY HEALTH DEPARTMENT AT LEAST EIGHT HOURS BEFORE TANK IS TO BE INSPECTED.

Final Inspection 4-12 1968 Approved (✓) Disapproved ( )

Remarks

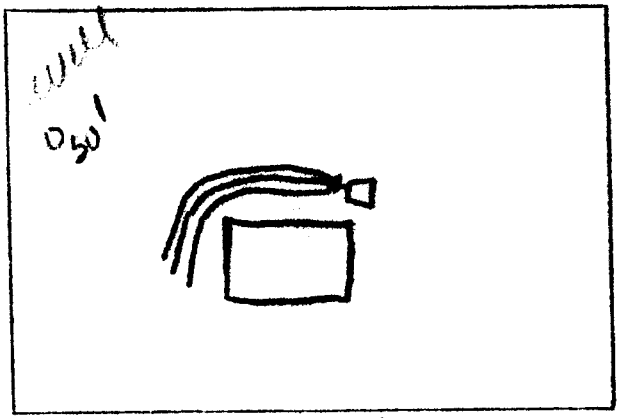

Sketch of Installation

E.S.

Edward J. Hutchinson

Sanitarian