IREDELL COUNTY HEALTH DEPARTMENT

Statesville Phone TR 3-7271 Mooresville Phone NO 3-1271

PERMIT TO INSTALL SEPTIC TANK

Permit NO. _____ Ross Sigmon Permit Date May 14 1963

Owner Robert R. Sherrill Address R2 City

Installed By C Hoke Address R7

Location of Property 4th Ls on left above Iredell Co. toward Wilkesboro.


Tank		Capacity		Length of Lines		Fixtures	
Block	( )	800	( )	150'	( )	No. of Baths	(1)
Precast	(L)	900	( )	175'	( )	Dishwasher	( )
		1000	(1)	200'	( )	Garbage Grdr.	( )
		1100	( )	225'	(4)	Auto-Washer	( )
		1200	( )	250'	( )	Other	
		Other		Other			

NOTIFY HEALTH DEPARTMENT AT LEAST EIGHT HOURS BEFORE TANK IS TO BE INSPECTED.

Final Inspection 5-14 1963 Approved (V) Disapproved ( )

Remarks New installion to replace existing layout

Well 50'

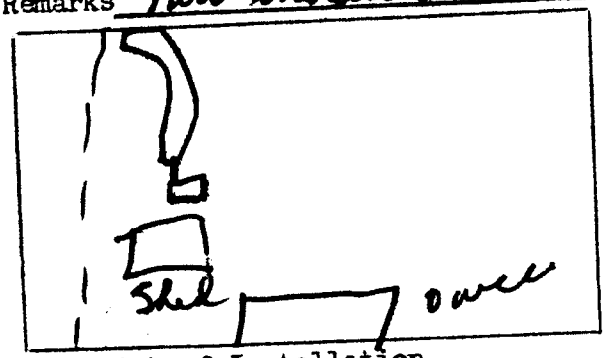

Sketch of Installation

Sanitarian