IREDELL COUNTY HEALTH DEPARTMENT

Statesville Phone TR 3-7271 Mooresville Phone NO 3-1271

PERMIT TO INSTALL SEPTIC TANK

Permit NO. _____ Permit Date Feb. 5 19 63

Owner Mr. Holland Address Statesville

Installed By Roy Long Address Statesville


Location of Property Turn off hwy 115 at Ball Oil Co. Third House on Left

Tank		Capacity		Length of Lines		Fixtures	
Block	( )	800	( )	150'	( )	No. of Baths	(1½
Precast	( )	900	( )	175'	( )	Dishwasher	( )
Pond		1000	(✓)	200'	( )	Garbage Grdr.	( )
		1100	( )	225'	(✓)	Auto-Washer	( )
		1200	( )	250'	( )	Other	
		Other		Other			

NOTIFY HEALTH DEPARTMENT AT LEAST EIGHT HOURS BEFORE TANK IS TO BE INSPECTED.

Final Inspection 2-5 1963 Approved (✓) Disapproved ( )

Remarks

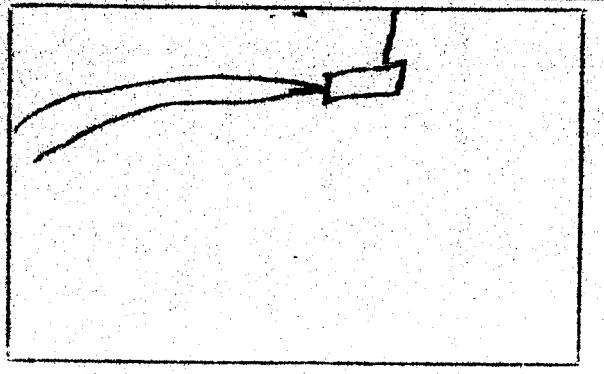

Sketch of Installation

written on the Property

R.L.

Sanitarian