IREDELL COUNTY HEALTH DEPARTMENT

Statesville Phone TR 3-7271 Mooresville Phone NO 3-1271

PERMIT TO INSTALL SEPTIC TANK

Permit NO._____ Permit Date APRIL 27, 1961

Owner BILL MORRISON Address RT #2 STATESVILLE

Installed By SAM GAITHER Address _____

Location of Property OUT #115 N. - RIGHT ON CHIPLEY FORD ROAD. ½ MILE ON LEFT — RIGHT ON PUMP STATION RD.


Tank		Capacity		Length of Lines		Fixtures	
Block	( )	800	( )	150'	( )	No. of Baths	(1)
Precast	(✓)	900	( )	175'	( )	Dishwasher	( )
		1000	(✓)	200'	( )	Garbage Grdr.	( )
		1100	( )	225'	(✓)	Auto-Washer	( )
		1200	( )	250'	( )	Other	_____
		Other	_____	Other	_____		

NOTIFY HEALTH DEPARTMENT AT LEAST EIGHT HOURS BEFORE TANK IS TO BE INSPECTED.

Final Inspection APRIL 27, 1961 Approved (✓) Disapproved ( )

Remarks CHIPLEY FORD 2-30" X 112½

EXCELLENT S.B.!!

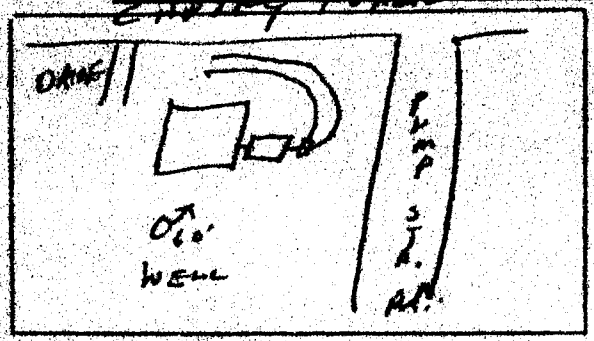

Sketch of Installation

Rufus G. Thomas

Sanitarian