IREDELL COUNTY HEALTH DEPARTMENT

Statesville Phone TR 3-7271 Mooresville Phone NO 3-1271

PERMIT TO INSTALL SEPTIC TANK

Permit NO._____ Permit Date 9-17-59 195__

Owner CLYDE HOKE Bob Barnes / Builder Address Beverly Hgts.

Installed By RT. 7 BOX 312 STATESVILLE, N. C. Address _____


Location of Property Out Chipley Ford rd. 1st dirt to right - 1 on right Lot # 8

Tank		Capacity		Length of Lines		Fixtures	
Block	( )	800	(✓)	150'	( )	No. of Baths	(2)
Precast	(✓)	900	( )	175'	( )	Dishwasher	( )
		1000	( )	200'	( )	Garbage Grdr.	( )
		1100	( )	225'	( )	Auto-Washer	(✓)
		1200	( )	250'	( )	Other _____	
		Other _____		Other 240			

NOTIFY HEALTH DEPARTMENT AT LEAST EIGHT HOURS BEFORE TANK IS TO BE INSPECTED.

Final Inspection 9 17 59 195_ Approved ( ) Disapproved ( )

Remarks Self apps. well - 75'

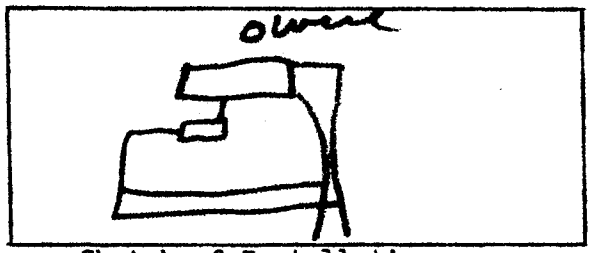

Sketch of Installation

R. L.

Sanitarian