IREDELL COUNTY HEALTH DEPARTMENT

Statesville Phone TR 3-7271 Mooresville Phone NO 3-1271

PERMIT TO INSTALL SEPTIC TANK

Permit NO. U L Deerhorn Bldg. Permit Date May 30 1962

Owner _____ Address Chipley Ford Rd

Installed By CLYDE HOKE Address _____


Location of Property On left before 1st Creek across from lake

Tank		Capacity		Length of Lines		Fixtures	
Block	( )	800	( )	150'	( )	No. of Baths	(1)
Precast	(✓)	900	( )	175'	( )	Dishwasher	( )
		1000	(✓)	200'	( )	Garbage Grdr.	( )
		1100	( )	225'	(✓)	Auto-Washer	(✓)
Cash		1200	( )	250'	( )	Other	_____
		Other	_____	Other	_____		

NOTIFY HEALTH DEPARTMENT AT LEAST EIGHT HOURS BEFORE TANK IS TO BE INSPECTED.

Final Inspection May 30 1962 Approved ( ) Disapproved ( )

Remarks well 100' Very bad fall

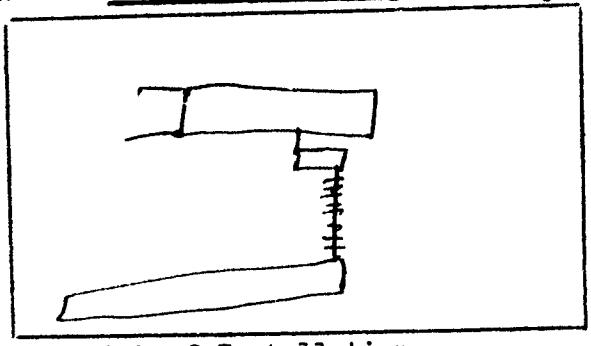

Sketch of Installation

_____

Sanitarian