IREDELL COUNTY HEALTH DEPARTMENT

STATESVILLE 704-878-5305 (C1) MOORESVILLE 704-664-5281

IMPROVEMENT PERMIT / AUTHORIZATION TO CONSTRUCT / OPERATION PERMIT / EXISTING SYSTEM INSPECTION

PERMIT# 089564 PIN# 4735488405 DATE 3-27-02

OWNER OR CONTRACTOR WILLIAM RODWELL PHONE: Business Home 704-872-8204

ADDRESS 315 BEVERLY DRIVE, STATESVILLE, NC, 28625

LOCATION NC 115 N, TR S. CHIPLEY FORD RD, 2ND DRIVE ON LEFT PAST MORRISON CREEK

SUBDIVISION BLOCK / SECTION LOT LOT AREA 4.5 ACRES SITE CLASS. PS DESIGN FLOW 480 L.T.A.R. 0.30 GPD/FT²

Septic Tank: 1500 Gallons; STB 797 Date 2-14-03
Pump Tank: Gallons; PT Date
Pump Make: Model Serial No.
Nitrification Field: No Fields 1 Square Feet 1600 Linear Feet 533
No Lines FOUR Trench Width 36" Max Trench Bottom Depth 36" Gravel Depth 12"

☑ New System ☐ Repair System Type: I II III IV V VI (25% REDUCTION)
System Description: 25% REDUCTION CONVENTIONAL GRAVITY
Repair System Description: 25% REDUCTION GRAV
Maintenance Agreement Required: ☐ Yes ☑ No


☑ House/Mod. Home No. Bedrooms 4
☐ Mobile Home No. Bathrooms 3½
☐ Business No. Employees
☐ Other
☐ Slab ☐ Crawl Space ☑ Basement w/plumbing ☐ Basement wo/plumbing

Water Supply: ☐ Individual ☑ Public ☐ Community


Comments:/Conditions:

Comments:/Conditions: CHANGED TO 25% REDUCTION SYSTEM TO ACCOMMODATE 5 BEDROOM HOUSE - PAID $130.00 BALANCE (2) SEPTIC TANK WITH RISERS INSTALLED USING "ZABEL" FILTER

INITIAL SITE SKETCH

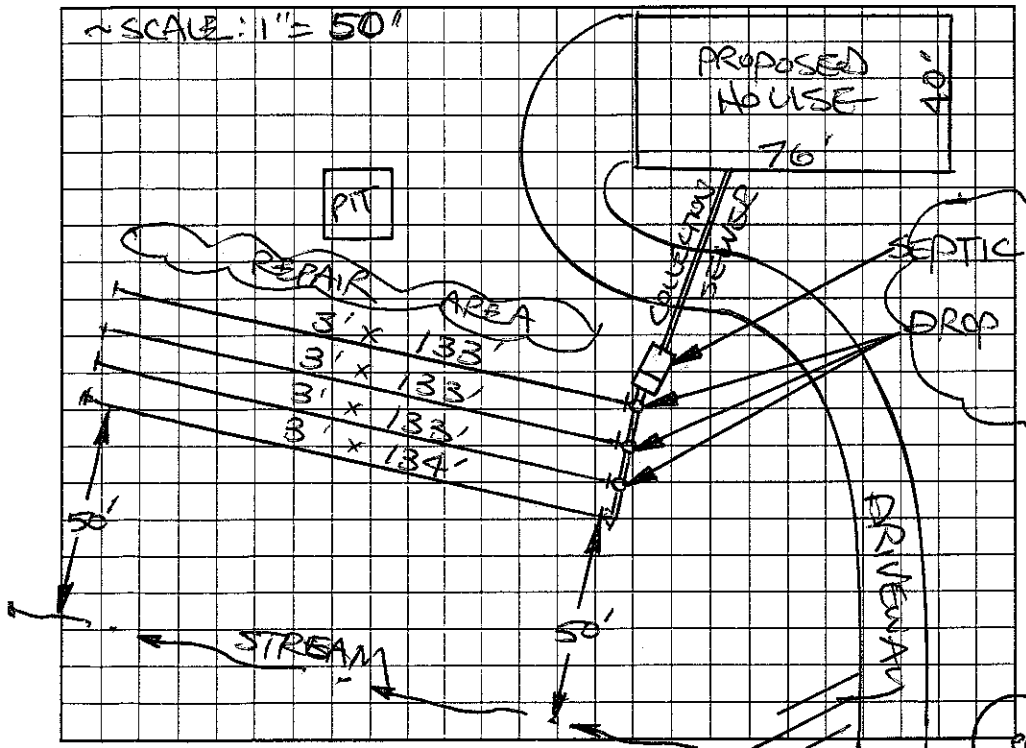

AS BUILT SKETCH

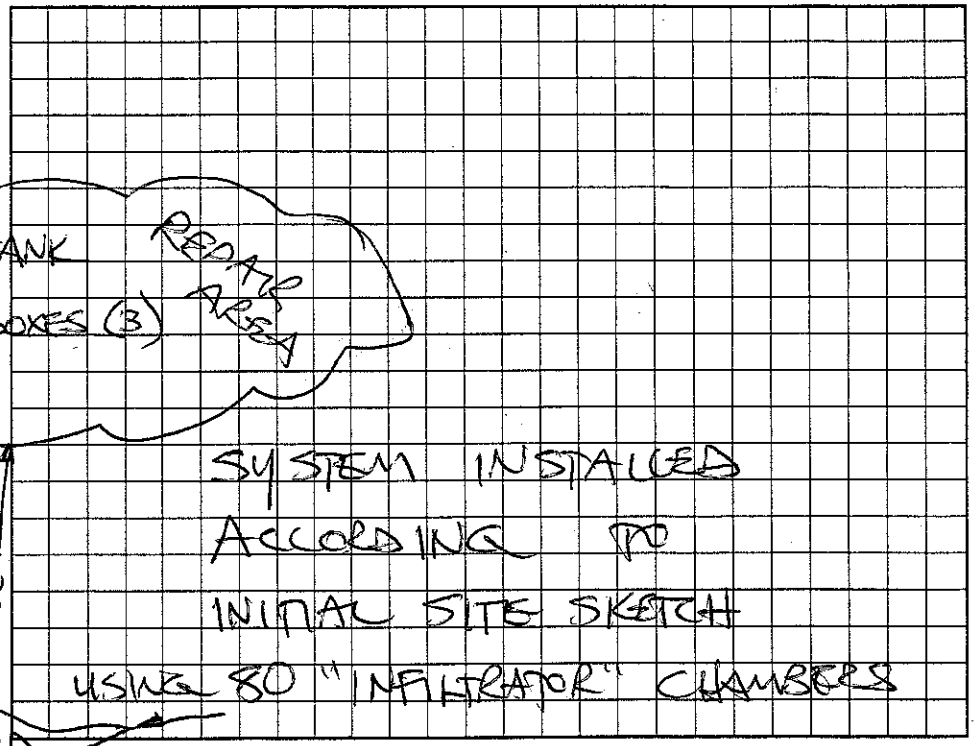

Permit can be suspended or revoked if any false information is supplied toward securing the permit/any unauthorized changes are made to the site/any unauthorized changes are made in the installation of the system. Improvement Permit with plat valid without expiration. Improvement Permit with site plan valid for sixty months. Authorization to Construct is valid for a period equal to that of Improvement Permit – not to exceed sixty months.

Signed: John L. Stikeleather Jr. date 3-27-02 Installed by: WES LYTTON

Improvement Permit by: STEVE HEDRICK date 3-27-02 Operation Permit by: STEVE HEDRICK date 3-31-03

Authorization to Construct by: STEVE HEDRICK date 3-27-02 Existing System Inspection by: date

HEALTH DEPT. COPY: WHITE OWNER COPY (FINAL): YELLOW OWNER COPY (INITIAL): PINK