IREDELL COUNTY HEALTH DEPARTMENT

STATESVILLE 704-878-5305 MOORESVILLE 704-664-5281

IMPROVEMENT PERMIT / AUTHORIZATION TO CONSTRUCT / OPERATION PERMIT / EXISTING SYSTEM INSPECTION

C1

PERMIT# 134055 PIN# 4735490385 4735490385 DATE 6/26/06

OWNER OR APPLICANT Jr. Clarence W Bell PHONE: Business 704 682 1705 Home 704 664 9360

ADDRESS 158 Canopy Oaks Lane

LOCATION Hwy 115, right Upper Oak Dr., right Canopy Oaks Lane,

SUBDIVISION Meadow Oaks II BLOCK / SECTION II LOT 96 LOT AREA .62 SITE CLASS. P5 DESIGN FLOW 360 L.T.A.R. .3

Septic Tank: 1000 Gallons; STB ~~1500~~ Date 4-15-06
Pump Tank: _____ Gallons; PT A1012 Date _____
Pump Make: _____ Model _____ Serial No. _____
Nitrification Field: No Fields 1 Square Feet 1200 Linear Feet 300
No Lines 7 Trench Width 36" Max Trench Bottom Depth 36" Gravel Depth _____

☐ New System ☐ Repair ☐ Expansion System Type: I II (III) IV V VI
System Description: Gravity 25% Reduction
Repair System Description: 50% Reduction LP
Maintenance Agreement Required: ☐ Yes ☒ No

☒ House/Mod. Home No. Bedrooms 3
☐ Mobile Home No. Persons _____
☐ Business No. Employees _____
☐ Other _____


Water Supply: ☒ Individual ☐ Public ☐ Community

☒ Gravity ☐ Pressure ☐ Slab ☒ Crawl Space ☐ Basement w/plumbing ☐ Basement wo/plumbing

Comments:/Conditions:

Comments:/Conditions:

INITIAL SITE SKETCH

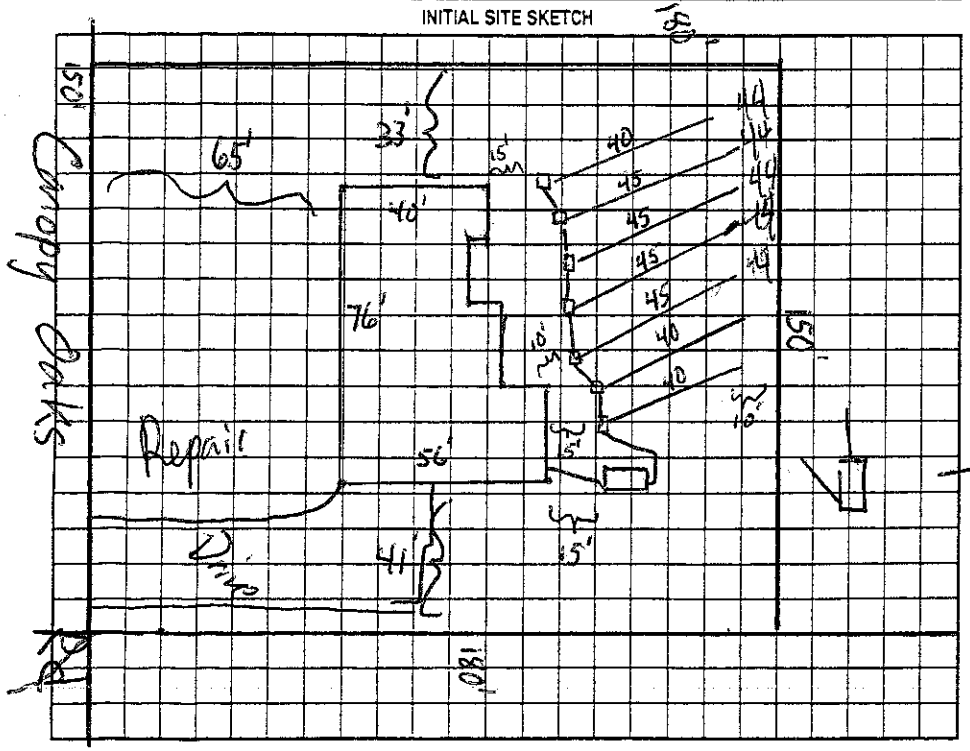

AS BUILT SKETCH

Permit can be suspended or revoked if any false information is supplied toward securing the permit/any unauthorized changes are made to the site/any unauthorized changes are made in the installation of the system. Improvement Permit with plat valid without expiration. ☐ Improvement Permit with site plan valid for sixty months ☐ Authorization to Construct is valid for a period equal to that of Improvement Permit – not to exceed sixty months.

Signed: Judy Bell date 6/30/06 Installed by: David Yountz

Improvement Permit by: James date 6/26/06 Operation Permit by: James date 12-29-06

Authorization to Construct by: James date 6/26/06 Existing System Inspection by: _____ date _____

HEALTH DEPT. COPY: WHITE OWNER COPY (FINAL): YELLOW OWNER COPY (INITIAL): PINK