# IREDELL COUNTY HEALTH DEPARTMENT

THIS PERMIT VOIDS PREVIOUS ISSUED 5-13-2000

STATESVILLE 704-878-5305 MOORESVILLE 704-664-5281

## IMPROVEMENT PERMIT / AUTHORIZATION TO CONSTRUCT / OPERATION PERMIT / EXISTING SYSTEM INSPECTION

PERMIT# 089004 PIN# 4735 39 4157 (PART) DATE 7-2-01

OWNER OR CONTRACTOR DONNIE NIEMANN PHONE: Business (704) 876-4217 Home

ADDRESS 149 CANOPY OAK LANE, STATESVILLE, NC 28625

LOCATION NC 115 N TR S. CHIPLEY FORD RD, TL CANOPY OAK LN 5TH & 6TH LOTS ON LEFT

SUBDIVISION MEADOW OAKS BLOCK / SECTION II LOT 106/107 LOT AREA ~~106/107~~ 1.285 ACRES SITE CLASS P3 DESIGN FLOW 600 L.T.A.R. 0.3 GPD/FT²

Septic Tank: 1500 Gallons: STB 268 Date 4-10-01

Pump Tank: _____ Gallons: PT _____ Date _____

Pump Make: _____ Model _____ Serial No. _____

Nitrification Field: No Fields 1 Square Feet Eq. to 2000 Linear Feet 500+

No Lines FIVE Trench Width 36" Max Trench Bottom Depth 36" Gravel Depth N/A

☑ New System ☐ Repair System Type: I, II, III, IV, V, VI

System Description: 25% REDUCTION, GRAVITY

Repair System Description: 25% REDUCTION, PUMP

Maintenance Agreement Required: ☐ Yes ☑ No

☑ House/Mod. Home No. Bedrooms 5

☐ Mobile Home No. Bathrooms 3

☐ Business No. Employees ____

☐ Other


☐ Slab ☑ Crawl Space ☐ Basement w/plumbing ☐ Basement wo/plumbing

Water Supply: ☐ Individual ☑ Public ☐ Community

Comments/Conditions: INSTALL 25% REDUCTION SYSTEM USING 83 CHAMBERS OR 50 HAS SECTIONS.

Comments/Conditions SEPTIC TANK WITH MARKER INSTALLED USING "PolyLok" FILTER

INITIAL SITE SKETCH

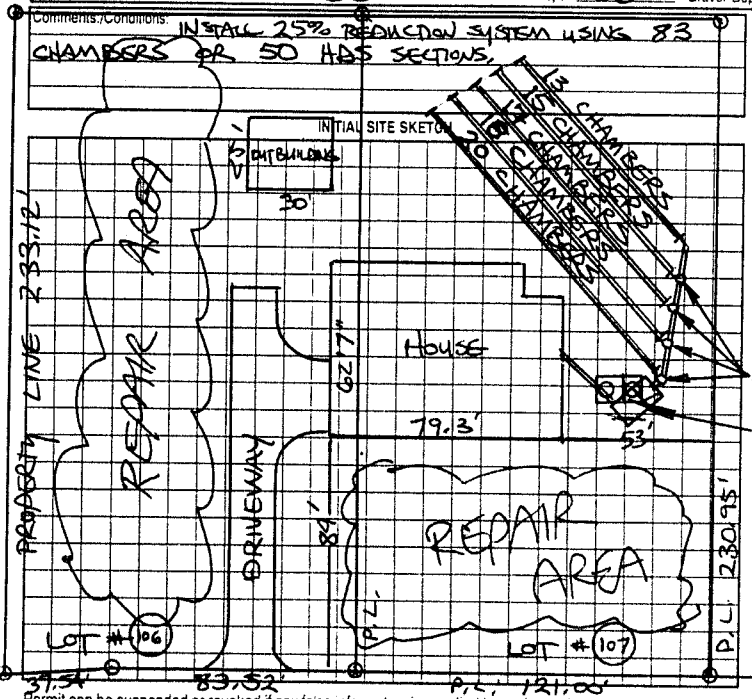


AS BUILT SKETCH

SCALE: 1" = 50'

SYSTEM INSTALLED USING 83 "BIODIFFUSER" CHAMBERS AS SHOWN

DROP BOXES (4)

SEPTIC TANK

Permit can be suspended or revoked if any false information is supplied toward securing the permit/any unauthorized changes are made to the site/any unauthorized changes are made in the installation of the system. Improvement Permit with plat valid without expiration. Improvement Permit with site plan valid for sixty months. Authorization to Construct is valid for a period equal to that of Improvement Permit – not to exceed sixty months.

Signed: Linda Niemann date 7-16-01

Improvement Permit by: STEVE HEDRICK date 7-2-01

Authorization to Construct by: STEVE HEDRICK date 7-2-01

Installed by: JAMES HUDLER

Operation Permit by: STEVE HEDRICK date 9-18-01

Existing System Inspection by: _____ date _____

HEALTH DEPT COPY WHITE OWNER COPY (FINAL) YELLOW OWNER COPY (INITIAL) PINK