IREDELL COUNTY HEALTH DEPARTMENT

STATESVILLE 704-878-5305 ✓ MOORESVILLE 704-664-5281

IMPROVEMENT PERMIT / AUTHORIZATION TO CONSTRUCT / OPERATION PERMIT / EXISTING SYSTEM INSPECTION

PERMIT# 104616 PIN# 4735-49-3385 DATE 2-20-02

OWNER OR CONTRACTOR RICHARD W. WILSON PHONE: Business 704-902-3511 Home 704-873-9034

ADDRESS 2210 JAMES WAY, STATESVILLE, NC 28625

LOCATION NC 115 N, TR S. CHIPLEY FORD RD, TL CANOPY OAK LN, 4TH LOT ON RIGHT

SUBDIVISION MEADOW OAKS BLOCK / SECTION II LOT 98 LOT AREA 0.58 ACRE SITE CLASS. PS DESIGN FLOW 360' L.T.A.R. 0.25 GPD/FT²

Septic Tank: 1000 Gallons; STB 1012 Date 4-5-02

Pump Tank: _____ Gallons; PT _____ Date _____

Pump Make: _____ Model _____ Serial No. _____

Nitrification Field: No. Fields 1 Square Feet EQ. TO 1490 Linear Feet 360

No Lines FOUR Trench Width 36" Max Trench Bottom Depth 36" Gravel Depth N/A

☑ New System ☐ Repair System Type: I, II, III, IV, V, VI

System Description: 25% REDUCTION GRAVITY

Repair System Description: 25% REDUCTION, PUMP

Maintenance Agreement Required: ☐ Yes ☑ No

☑ House/Mod. Home No. Bedrooms 3

☐ Mobile Home No. Bathrooms 2½

☐ Business No. Employees ____

☐ Other _____


☐ Slab ☑ Crawl Space ☐ Basement w/plumbing ☐ Basement wo/plumbing

Water Supply: ☐ Individual ☑ Public ☐ Community


Comments:/Conditions: INSTALL 25% REDUCTION SYSTEM; GRADE LOT TO PROVIDE UNIFORM DRAINAGE

Comments:/Conditions: - Polyloc filter Installed
- S.T. marker Installed
- Infiltrator Chambers Installed.

INITIAL SITE SKETCH

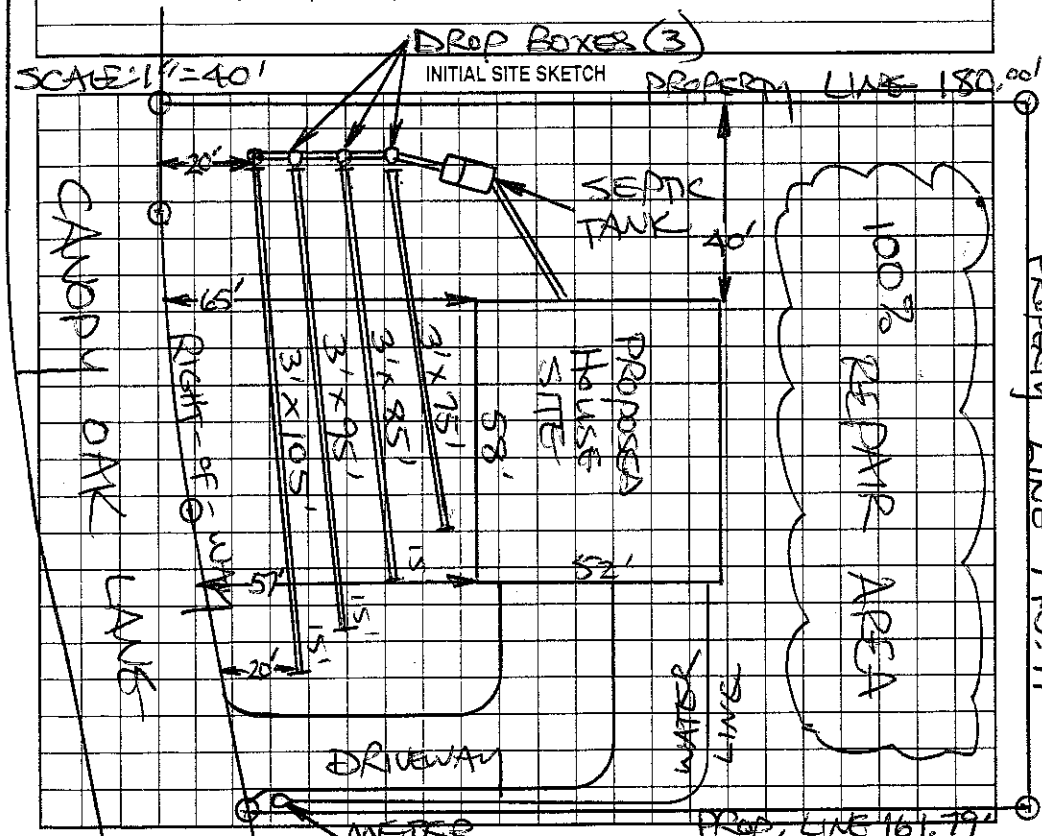

AS BUILT SKETCH

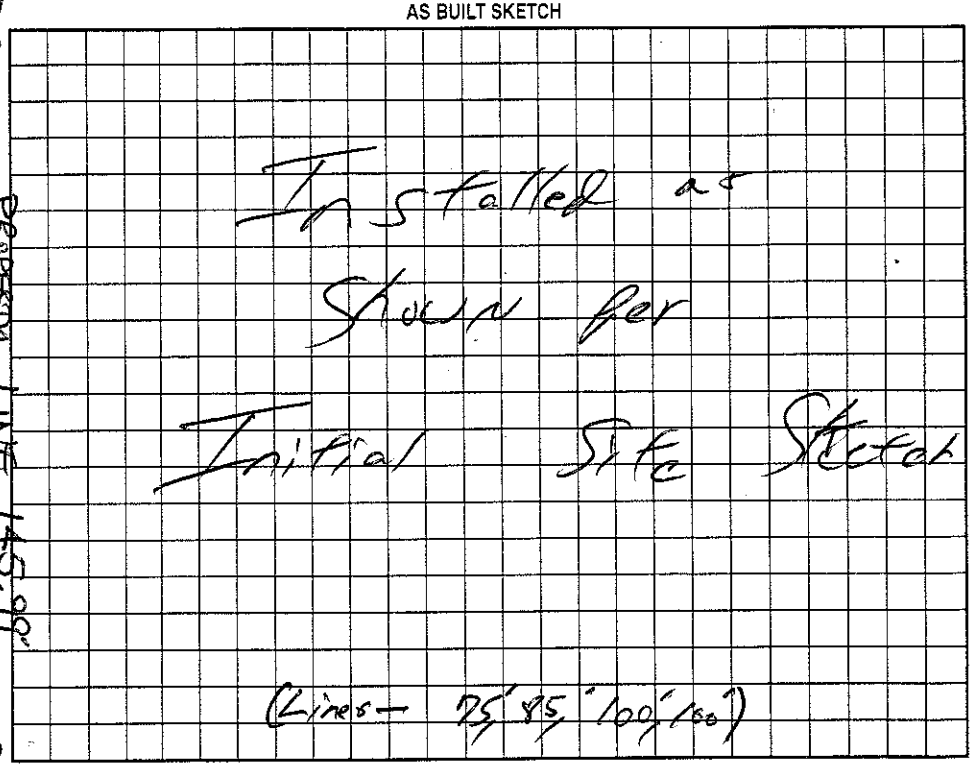

Permit can be suspended or revoked if any false information is supplied toward securing the permit/any unauthorized changes are made to the site/any unauthorized changes are made in the installation of the system. Improvement Permit with plat valid without expiration. Improvement Permit with site plan valid for sixty months. Authorization to Construct is valid for a period equal to that of Improvement Permit – not to exceed sixty months.

Signed: Richard W. Wilson date 2/20/02 Installed by: David Younts

Improvement Permit by: STEVE HEDRICK date 2-20-02 Operation Permit by: William O. Johnson date 6/29/02

Authorization to Construct by: STEVE HEDRICK date 2-20-02 Existing System Inspection by: _____ date _____

HEALTH DEPT. COPY: WHITE OWNER COPY (FINAL): YELLOW OWNER COPY (INITIAL): PINK