IREDELL COUNTY HEALTH DEPARTMENT

STATESVILLE 704-878-5305 CI MOORESVILLE 704-664-5281

IMPROVEMENT PERMIT / AUTHORIZATION TO CONSTRUCT / OPERATION PERMIT / EXISTING SYSTEM INSPECTION

DATE 10/26/07

PERMIT# 145441 PIN# 4735494121

OWNER OR APPLICANT KA Watt Construction, LLC PHONE: Business 704 876 0047 Home

ADDRESS 141 Canopy Oak Lane

LOCATION 115N Rt on S. Chipley Ford, (L) on Canopy Oak, House on (R)

SUBDIVISION Meadow Oaks II BLOCK / SECTION III LOT 105 LOT AREA SITE CLASS. B DESIGN FLOW 480 L.T.A.R. .3

Septic Tank: 1000 Gallons: STB 1042 Date 9-5-07

Pump Tank: Gallons: PT Date

Pump Make: Model Serial No.

Nitrification Field: No Fields 1 Square Feet 1600 Linear Feet 400

No Lines 4 Trench Width 36" Max Trench Bottom Depth 36" Gravel Depth

☒ New System ☐ Repair ☐ Expansion System Type: I (II) III IV V VI

System Description: 25% Reduction Gravity

Repair System Description: 50% LP Reduction

Maintenance Agreement Required: ☐ Yes ◉ No

◉ Gravity ☐ Pressure

◉ House/Mod. Home ☐ Mobile Home ☐ Business ☐ Other

No. Bedrooms 4 No. Persons No. Employees


Water Supply: ☐ Individual ◉ Public ☐ Community

☐ Slab ◉ Crawl Space ☐ Basement w/plumbing ☐ Basement wo/plumbing

Comments:/Conditions:

Comments:/Conditions:

INITIAL SITE SKETCH

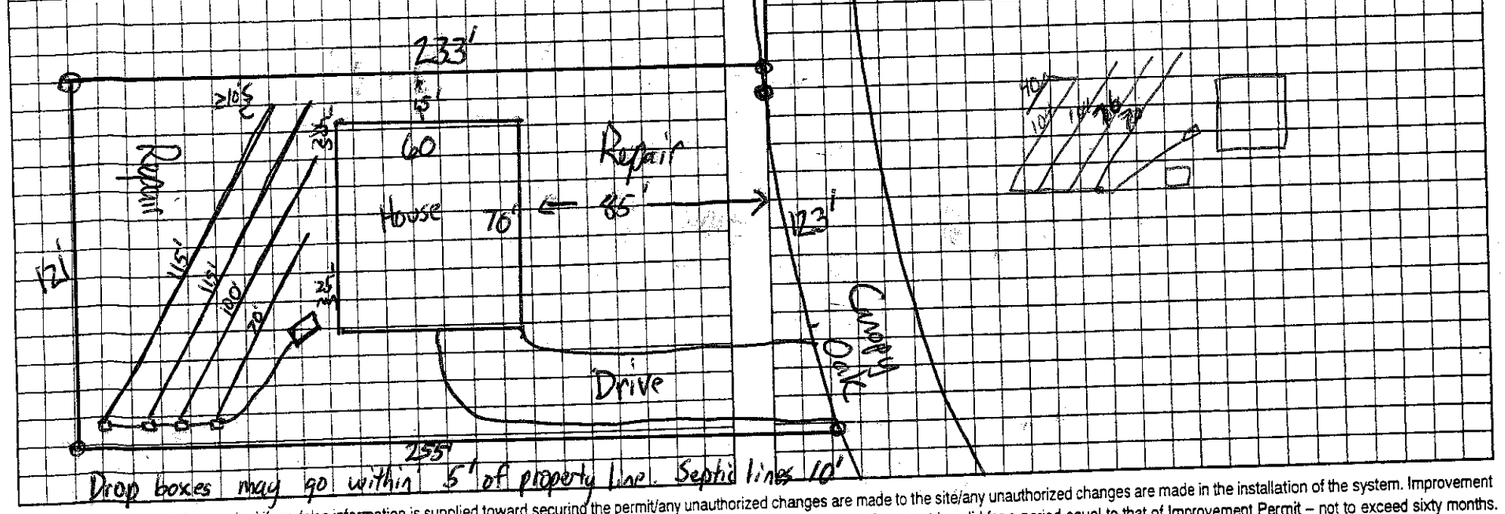

AS BUILT SKETCH

Drop boxes may go within 5' of property line. Septic lines 10'

Permit can be suspended or revoked if any false information is supplied toward securing the permit/any unauthorized changes are made to the site/any unauthorized changes are made in the installation of the system. Improvement Permit with plat valid without expiration ☐ Improvement Permit with site plan valid for sixty months ☒ Authorization to Construct is valid for a period equal to that of Improvement Permit – not to exceed sixty months.

Signed: Kenneth Watt date 10-29-07 Installed by: David Huntz

Improvement Permit by: date 10/26/07 Operation Permit by: date 6-2-8

Authorization to Construct by: date 10/26/07 Existing System Inspection by: date

HEALTH DEPT. COPY: WHITE OWNER COPY (FINAL): YELLOW OWNER COPY (INITIAL): PINK