230 Meadow Oaks Drive, Statesville 4735.49.4998.000

53651

IREDELL COUNTY HEALTH DEPARTMENT

STATESVILLE 704-878-5305 MOORESVILLE 704-664-5281

IMPROVEMENT PERMIT / CERTIFICATE OF COMPLETION / OPERATION PERMIT / EXISTING SYSTEM INSPECTION

PROPERTY DESCRIPTION NO. 19782 DATE 11/22/94 TAX MAP NO. 10D-1-A-7 Watershed: ☐ Yes ☑ No

OWNER OR CONTRACTOR SELF HOMES PHONE: Business Home 873-9612

ADDRESS P.O. BOX 1283 STATESVILLE NC 28677

LOCATION NC 115 N, TR SULLIVAN FARM RD, TR MEADOW OAKS DRIVE, ON (R) NEAR END

SUBDIVISION MEADOW OAKS BLOCK / SECTION LOT 7 LOT AREA 130 x ~250 SITE CLASS P'S DESIGN FLOW 360 L.T.A.R. 0.35 GPD/FT²

Septic Tank: 1000 Gallons; STB 794 Date 2/20/95

Pump Tank: Gallons; PT Dose

Pump Make: Model Serial No.

Nitrification Field: No Fields 1 Square Feet 1035 Lineal Feet 345

No Lines 4 Trench Width 36" Max Trench Bottom Depth 18-36" Gravel Depth 12"

☑ New System ☐ Repair System Type: I II III IV V VI

System Description: CONVENTIONAL GRAVITY

Repair System Description: CONV. GRAVITY

Maintenance Agreement Required: ☐ Yes ☑ No

☐ Slab ☑ Crawl Space ☐ Basement w/plumbing ☐ Basement wo/plumbing

☑ House/Mod. Home No. Bedrooms 3

☐ Mobile Home No. Bathrooms 2½

☐ Business No. Employees

☐ Other


Water Supply: ☐ Individual ☐ Community ☑ Public

4624174762.000

Comments:

Comments:

INITIAL SITE SKETCH

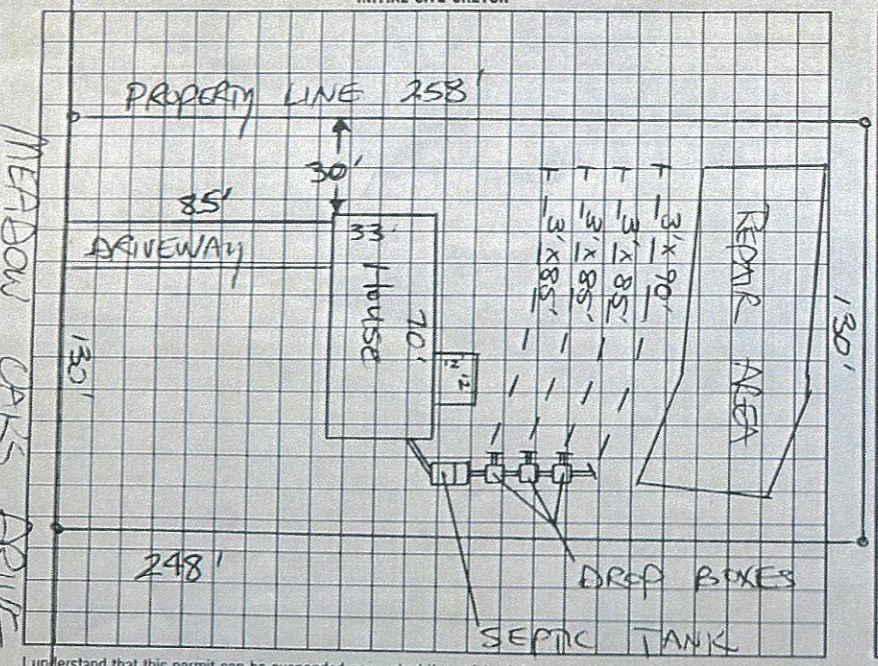

AS BUILT SKETCH

SYSTEM INSTALLED ACCORDING TO INITIAL SITE SKETCH

I understand that this permit can be suspended or revoked if any false information is supplied toward securing the permit/any unauthorized changes are made to the site/any unauthorized changes are made in the installation of the system. Improvement Permit is valid for 60 months from date of issuance.

Signed: SELF HOMES, INC By: W. B. S. PRESIDENT

Improvement Permit by: STEVE HEDRICK date 11/22/94

Existing System Inspection by: date

Installed by: JAMES HYALER

Certificate of Completion by: STEVE HEDRICK date 4/17/95

Operation Permit by: date

HEALTH DEPT. COPY: WHITE INSPECTION COPY (FINAL): GREEN OWNER COPY (FINAL): YELLOW INSPECTION COPY (INITIAL): PINK OWNER COPY (INITIAL): GOLD