11:00

IREDELL COUNTY HEALTH DEPARTMENT

CT STATESVILLE 704-878-5305 MOORESVILLE 704-664-5281

IMPROVEMENT PERMIT / AUTHORIZATION TO CONSTRUCT / OPERATION PERMIT / EXISTING SYSTEM INSPECTION

PERMIT# 143339 PIN# 4735495348 DATE 6/29/07

OWNER OR APPLICANT Michael Landon Levan PHONE: Business 704-902-6860 Home 704-902-6866

ADDRESS 134 Canopy Oak

LOCATION Hwy 115 N (R) Upper Oak Dr. (R) on Canopy Oak, lot on left

SUBDIVISION Meadow Oaks BLOCK / SECTION II LOT 99 LOT AREA .6056 SITE CLASS. PS DESIGN FLOW 480 L.T.A.R. .4

Septic Tank: 1000 Gallons; STB 1012 Date 4-9-07
Pump Tank: ____ Gallons; PT ____ Date ____
Pump Make: ____ Model ____ Serial No. ____
Nitrification Field: No Fields 1 Square Feet 1200 Linear Feet 300
No Lines 4 Trench Width 36" Max Trench Bottom Depth 36" Gravel Depth ____

☒ New System ☐ Repair ☐ Expansion System Type: I (II) III IV V VI
System Description: 25% Reduction Gravity
Repair System Description: 25% Reduction - Pump
Maintenance Agreement Required: ☐ Yes ☐ No


☒ House/Mod. Home ☐ Mobile Home ☐ Business ☐ Other
No. Bedrooms 4 No. Persons ____ No. Employees ____

Water Supply: ☒ Individual ☐ Public ☐ Community

☒ Gravity ☐ Pressure ☐ Slab ☒ Crawl Space ☐ Basement w/plumbing ☐ Basement wo/plumbing


Comments:/Conditions:

INITIAL SITE SKETCH

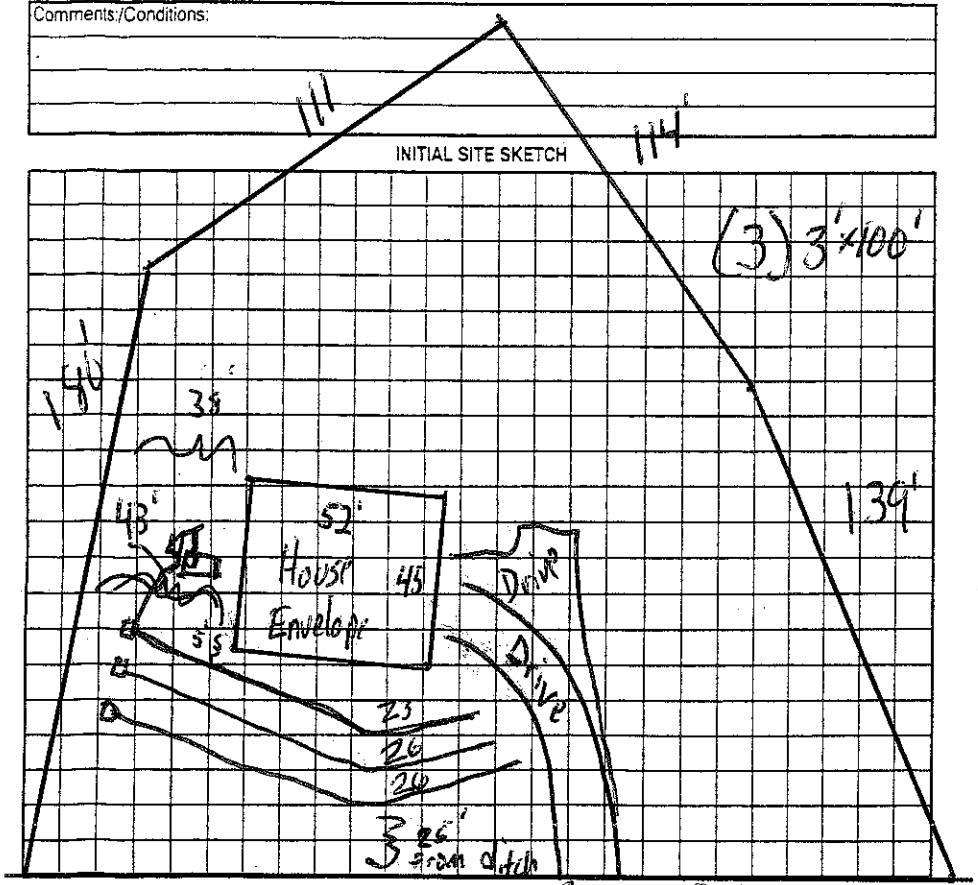

Comments:/Conditions:

AS BUILT SKETCH

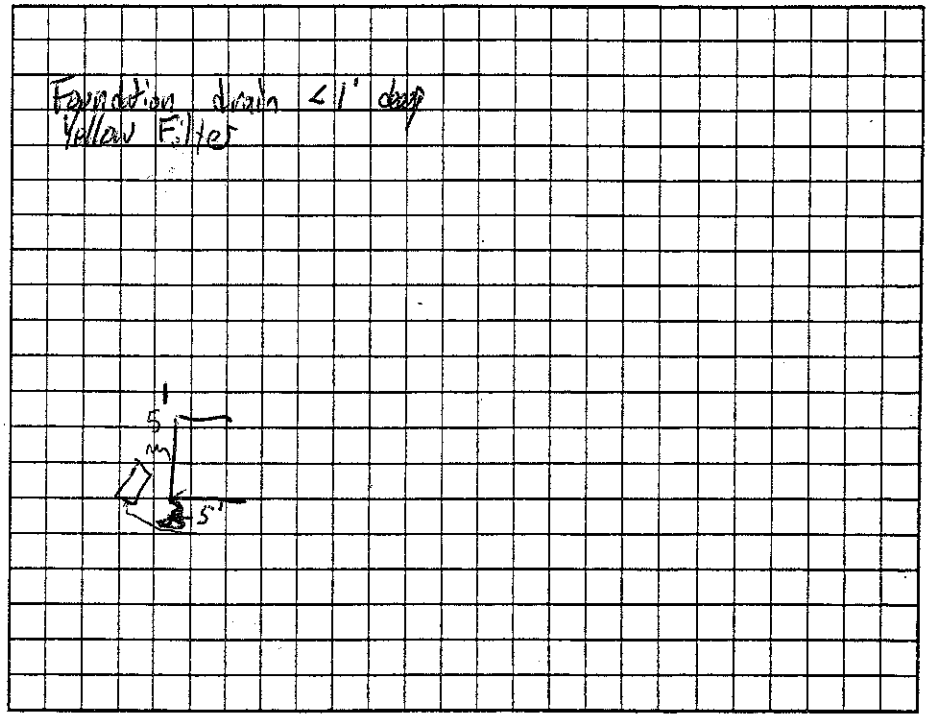

Permit can be suspended or revoked if any false information is supplied toward securing the permit/any unauthorized changes are made to the site/any unauthorized changes are made in the installation of the system. Improvement Permit with plat valid without expiration ☐ Improvement Permit with site plan valid for sixty months ☐ Authorization to Construct is valid for a period equal to that of Improvement Permit – not to exceed sixty months.

Signed: ____ date ____ Installed by: C&S Grading

Improvement Permit by: ____ date 6-29-07 Operation Permit by: ____ date 11/9/07

Authorization to Construct by: ____ date 6-29-07 Existing System Inspection by: ____ date ____

HEALTH DEPT. COPY: WHITE OWNER COPY (FINAL): YELLOW OWNER COPY (INITIAL): PINK