IREDELL COUNTY HEALTH DEPARTMENT

STATESVILLE 704-878-5305 CI MOORESVILLE 704-664-5281

IMPROVEMENT PERMIT / AUTHORIZATION TO CONSTRUCT / OPERATION PERMIT / EXISTING SYSTEM INSPECTION

PERMIT# 114589 PIN# 4735-49-6791 DATE 9/15/03

OWNER OR CONTRACTOR David Meehan PHONE: Business 902-0286 Home (704) 528-6378

ADDRESS 111 Wheatridge Drive Statesville NC 28677

LOCATION Hwy 115 N (R) Chipley Ford (L) Canopy Oak (R) Wheatridge 3rd on left.

SUBDIVISION Meadow Oaks BLOCK / SECTION 3 LOT 124 LOT AREA .526 Ac SITE CLASS PS DESIGN FLOW 360 L.T.A.R. .25 gpd/ft²

Septic Tank: 4000 Gallons; STB 794 Date 2-1-04
Pump Tank: 4000 Gallons; PT 283 Date 1-9-04
Pump Make: Zoeller Model BN98B Serial No. –
Nitrification Field: No Fields 1 Square Feet Bay to 440 Linear Feet 360
No Lines 3@120' Trench Width 36" Max Trench Bottom Depth 30" Gravel Depth N/A

☒ New System ☐ Repair System Type: I, II, (III) IV, V, VI
System Description: Pump 25% Reduction
Repair System Description: Pump, LP Panels
Maintenance Agreement Required: ☐ Yes ☒ No


☒ House/Mod. Home No. Bedrooms 3
☐ Mobile Home No. Bathrooms 2½
☐ Business No. Employees ___
☐ Other ___
☐ Slab ☒ Crawl Space ☐ Basement w/plumbing ☐ Basement wo/plumbing

Water Supply: ☐ Individual ☒ Public ☐ Community


Comments:/Conditions: ① Install lines on contour ② maintain proper setbacks ③ No cutting or filling over septic system area!!
– Prior HD approval to move S.T. + P.T. to opposite side of drainfield.

Comments:/Conditions: – 58 Infiltrator Chambers Installed
– Zabel Filter Installed + ST Risers Installed
– Lines okay, Pressure check, Electrical + Alarm okay.

INITIAL SITE SKETCH 1" = 50 ft

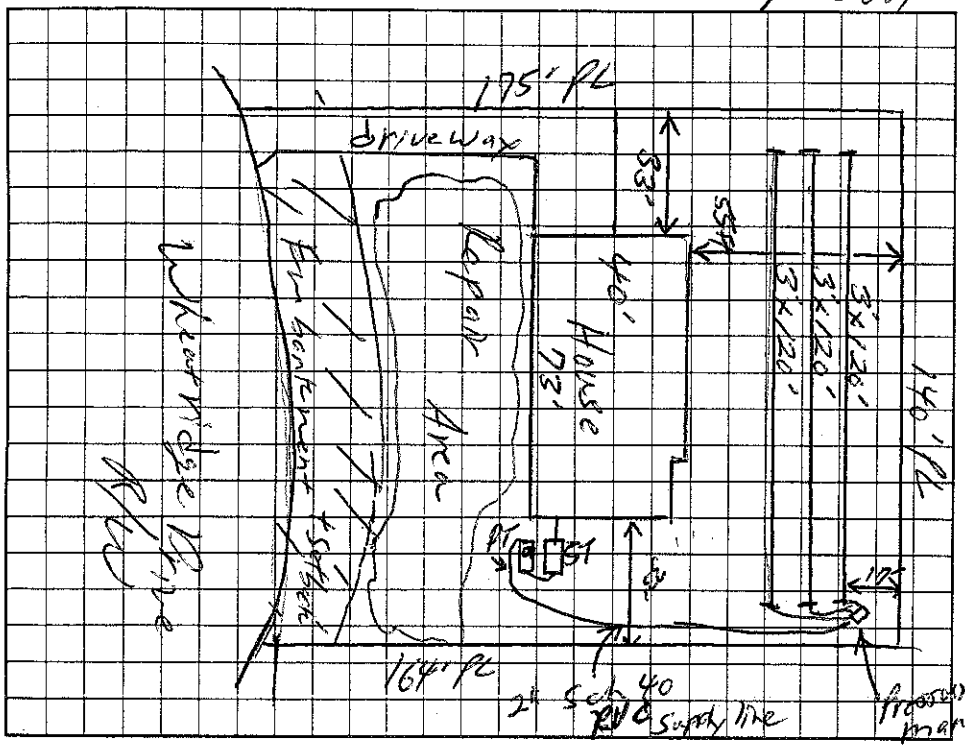

AS BUILT SKETCH

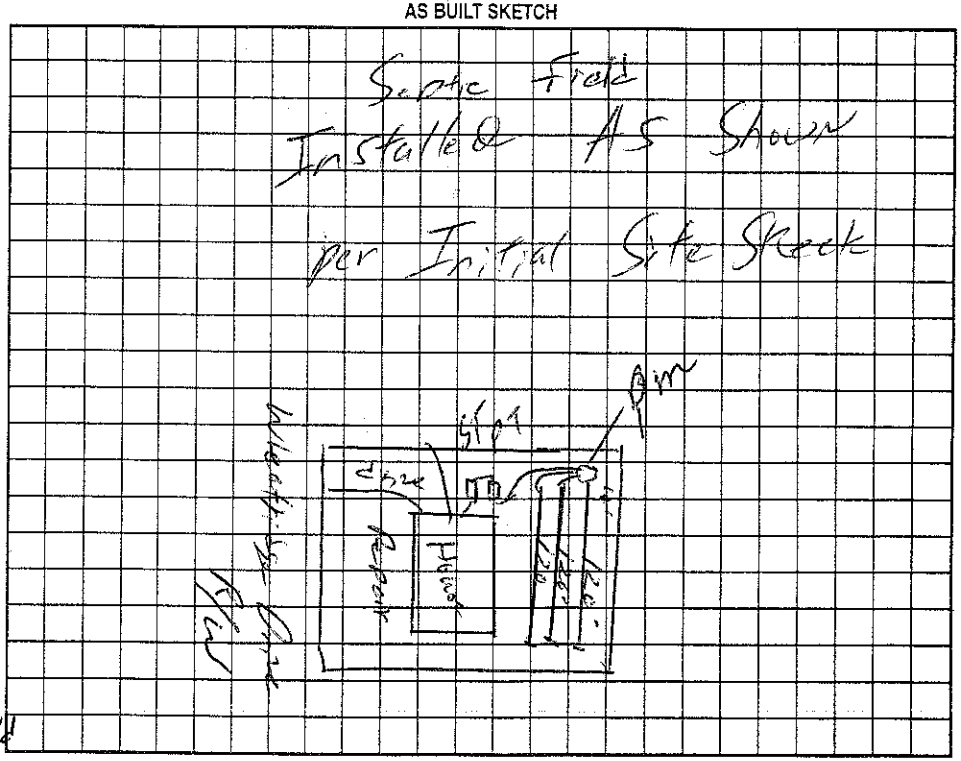

Permit can be suspended or revoked if any false information is supplied toward securing the permit/any unauthorized changes are made to the site/any unauthorized changes are made in the installation of the system. Improvement Permit with plat valid without expiration. Improvement Permit with site plan valid for sixty months. Authorization to Construct is valid for a period equal to that of Improvement Permit – not to exceed sixty months.

Signed: David Meehan date 9-16-03 Installed by: James Hadley

Improvement Permit by: William O. Johnson date 9/15/03 Operation Permit by: William O. Johnson date 3/12/04

Authorization to Construct by: William O. Johnson date 9/15/03 Existing System Inspection by: ___ date ___

HEALTH DEPT. COPY: WHITE OWNER COPY (FINAL): YELLOW OWNER COPY (INITIAL): PINK