IREDELL COUNTY HEALTH DEPARTMENT

STATESVILLE 704-878-5305 (CI) MOORESVILLE 704-664-5281

IMPROVEMENT PERMIT / AUTHORIZATION TO CONSTRUCT / OPERATION PERMIT / EXISTING SYSTEM INSPECTION

PERMIT# 128893 PIN# 4735 497 507 DATE 7/29/05

OWNER OR CONTRACTOR George & Teresa A Gregory PHONE: Business 704 913 0019 Home 704 876 2532

ADDRESS 105 Big Oak Ln Statesville, NC 28625

LOCATION 2 IN ⓞ Ft Dobbs Rd Ⓛ Chipley Ford Rd Ⓡ Canopy Oak Ln Ⓠ Wheatridge Dr Ⓘ Lot 111 Wheatridge Dr. site address

SUBDIVISION Meadow Oaks III BLOCK / SECTION III LOT 123 LOT AREA .56 ACRES SITE CLASS. PS DESIGN FLOW 360 gpd L.T.A.R. .3

Septic Tank: 1000 Gallons; STB 1012 Date 7-26-05
Pump Tank: 1000 Gallons; PT 17 Date 1-20-06
Pump Make: Goulds Model WE0712H Serial No. K0569139
Nitrification Field: No Fields 1 Square Feet 1200 Linear Feet 300
No Lines 3 Trench Width 36" Max Trench Bottom Depth 24" Gravel Depth N/A

☒ New System ☐ Repair System Type: I, II, (III), IV, V, VI
System Description: PWP 25% Reduction
Repair System Description: GRAV. W/ PODS
Maintenance Agreement Required: ☐ Yes ☒ No


☒ House/Mod. Home No. Bedrooms 3
☐ Mobile Home No. Bathrooms ____
☐ Business No. Employees ____
☐ Other ____
☐ Slab ☒ Crawl Space ☐ Basement w/plumbing ☐ Basement wo/plumbing

Water Supply: ☐ Individual ☒ Public ☒ Community


Comments/Conditions: install on contour. Maintain setbacks.
See attached pump design sheets.
SCALE: 1"=50'

Comments/Conditions: SEPTIC TANK W/ MARKER INSTALLED
USING "TUFTITE" FILTER

INITIAL SITE SKETCH

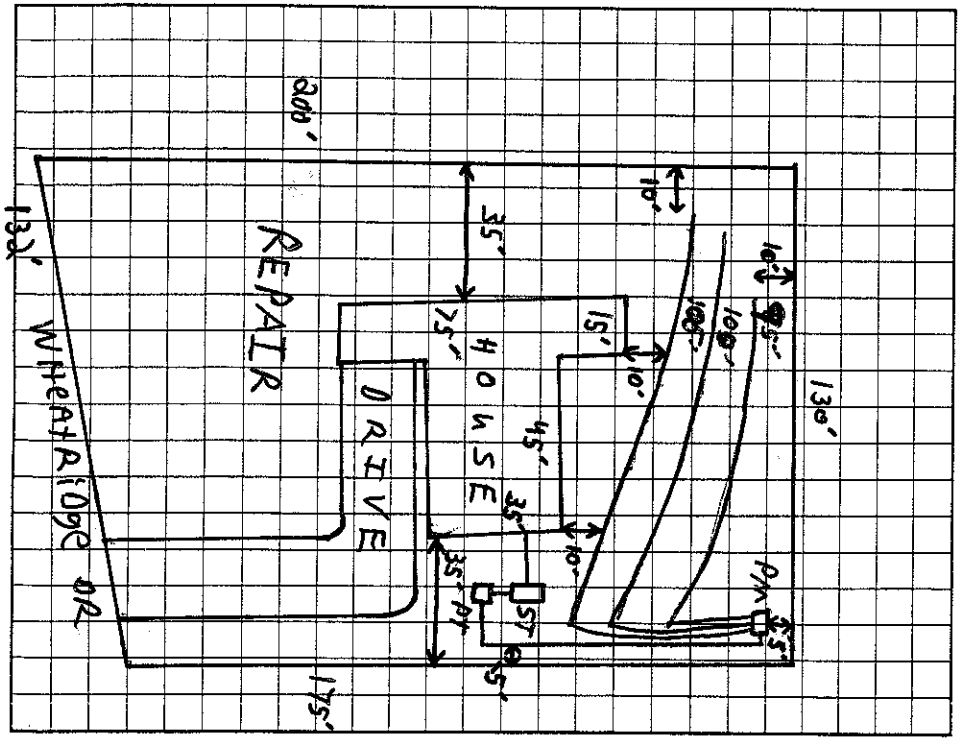

AS BUILT SKETCH

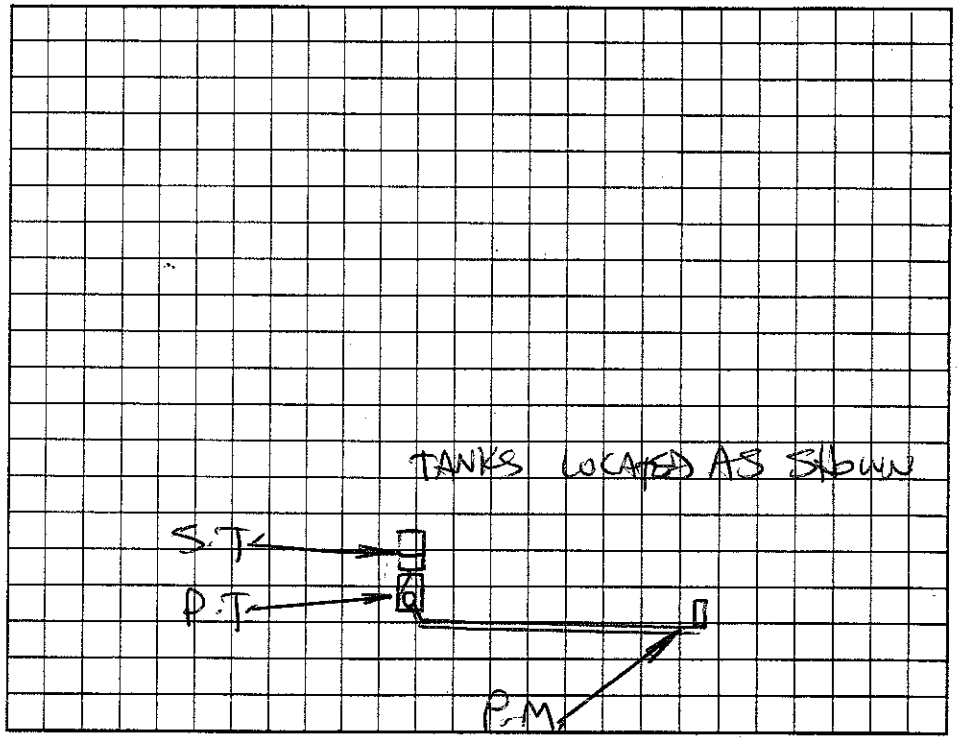

Permit can be suspended or revoked if any false information is supplied toward securing the permit/any unauthorized changes are made to the site/any unauthorized changes are made in the installation of the system. Improvement Permit with plat valid without expiration. Improvement Permit with site plan valid for sixty months. Authorization to Construct is valid for a period equal to that of Improvement Permit – not to exceed sixty months.

Signed: [signature] date 8-3-05

Improvement Permit by: [signature] date 7/29/05

Authorization to Construct by: STEVE HENDRICK date 8-3-05

Installed by: TOMMY FRYE

Operation Permit by: [signature] date 4-27-06

Existing System Inspection by: ____ date ____

HEALTH DEPT. COPY: WHITE OWNER COPY (FINAL): YELLOW OWNER COPY (INITIAL): PINK