IREDELL COUNTY HEALTH DEPARTMENT

Statesville Phone TR 3-7271 Mooresville Phone No. 664-5281

PERMIT TO INSTALL SEPTIC TANK

Permit No. _____ Permit Date 4-6 1973

Owner GLENN Josey Address N. CENTER ST STATESVILLE,

Installed By LACKEY Bros Address Stony Point, N.C.

Location of Property


Corner of Bowen Dr and N. Center St.

Tank	Capacity		Length of Lines		Fixtures	
Block	1000	( )	225'	( )	No. of Baths	( )
Precast	1250	( )	250'	( )	Dishwasher	( )
Repair	1500	( )	Other 180		Garbage Grdr.	( )
	Other _____				Other _____	

NOTIFY HEALTH DEPARTMENT AT LEAST EIGHT HOURS BEFORE TANK IS TO BE INSPECTED.

Final Inspection _____ 19__ Approved ( ) Disapproved ( )

Remarks _____

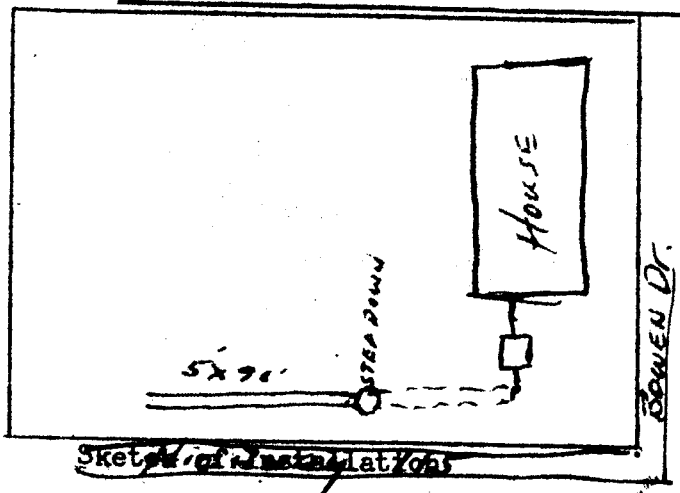

Sketch of Installation

Sanitarian