IREDELL COUNTY HEALTH DEPARTMENT

Statesville Phone TR 3-7271 Mooresville Phone NO 3-1271

PERMIT TO INSTALL SEPTIC TANK

Permit NO. _____ Permit Date _____ 19___

Owner T. D. Lucas Address Statesville

Installed By Roy D. Link Address Statesville


Location of Property Front Lucas on left of Dirt Rd. out past Trull's Co.

| Tank | | Capacity | | Length of Lines | | Fixtures | |
|---|---|---|---|---|---|---|---|
| Block | ( ) | 800 | ( ) | 150' | (✓) | No. of Baths | (✓) |
| Precast | (✓) | 900 | ( ) | 175' | ( ) | Dishwasher | ( ) |
| Cement | | 1000 | (✓) | 200' | ( ) | Garbage Grdr. | ( ) |
| | | 1100 | ( ) | 225' | ( ) | Auto-Washer | ( ) |
| | | 1200 | ( ) | 250' | ( ) | Other | _____ |
| | | Other | _____ | Other | _____ | | |

NOTIFY HEALTH DEPARTMENT AT LEAST EIGHT HOURS BEFORE TANK IS TO BE INSPECTED.

Final Inspection _____ 19___ Approved ( ) Disapproved ( )

Remarks _____

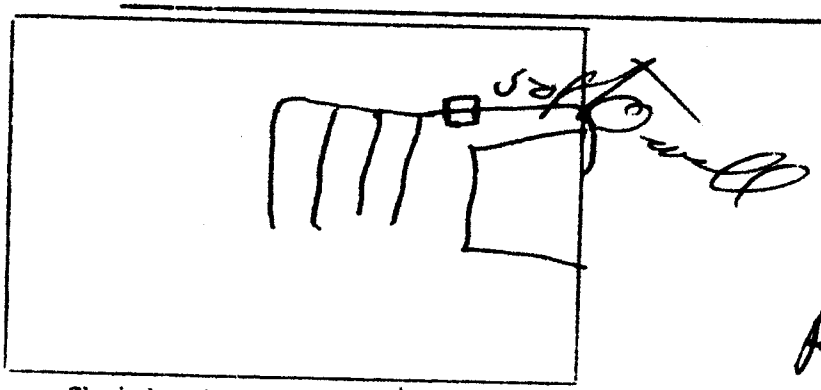


Sketch of Installation

Rest.

Sanitarian