IREDELL COUNTY HEALTH DEPARTMENT

Statesville Phone TR 3-7271 Mooresville Phone NO 3-1271

PERMIT TO INSTALL SEPTIC TANK

Permit No. _____ Permit Date April 19 19 57

Owner Buster McLellan Address Pump Sta. Rd

Installed By C Hoke Address R 7


Location of Property 5th house on R - on Pump Sta. Rd. - Off Shipley Ford Rd.

Tank		Capacity		Length of Lines		Fixtures	
Block	( )	1000	( )	225'	( )	No. of Baths	(2½
Precast	(✓)	1250	( )	250'	( )	Dishwasher	(✓)
		1500	( )	Other 240'		Garbage Grdr.	( )
		Other				Other	

NOTIFY HEALTH DEPARTMENT AT LEAST EIGHT HOURS BEFORE TANK IS TO BE INSPECTED.

Final Inspection _____ 19___ Approved ( ) Disapproved ( )

Remarks City water - owner says he may sell part of next lot, but he failed to mention before drain line run over on lot. He said not to worry he would take care of it.

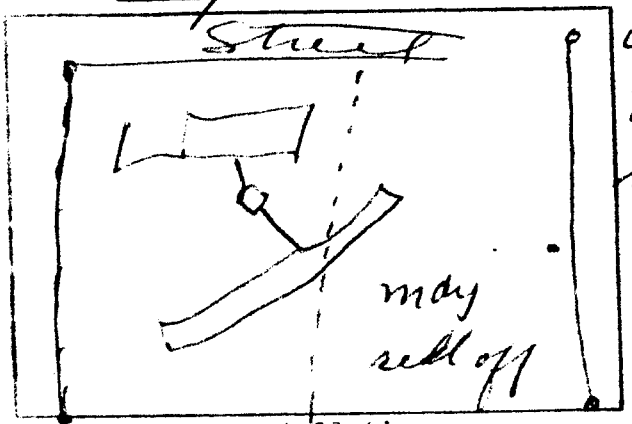

Sketch of Installation

Sanitarian