IREDELL COUNTY HEALTH DEPARTMENT

Statesville Phone TR 3-7271 Mooresville Phone NO 3-1271

PERMIT TO INSTALL SEPTIC TANK

Permit No. _____ Permit Date _____ 19__

Owner Sam Gaither Address _____

Installed By Sam Gaither Address _____


Location of Property Museum Sect. Kenmore Drive. Lot # 26. Community water

Tank		Capacity		Length of Lines		Fixtures	
Block	( )	1000	( )	225'	( )	No. of Baths	(2)
Precast	(✓)	1250	( )	250'	( )	Dishwasher	( )
		1500	( )	Other 240' MIN.	(✓)	Garbage Grdr.	( )
		Other				Other	

NOTIFY HEALTH DEPARTMENT AT LEAST EIGHT HOURS BEFORE TANK IS TO BE INSPECTED.

Final Inspection 7-25 1972 Approved (✓) Disapproved ( )

Remarks This tank installed without Health Dept. Approval. System uncovered by Gaither at request of Health Dept. Too close to property line.

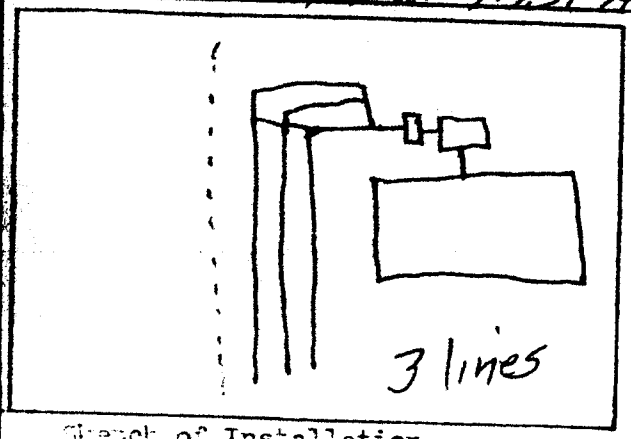

Sketch of Installation

Street

Sanitarian