IREDELL COUNTY HEALTH DEPARTMENT

Statesville Phone TR 3-7271 Mooresville Phone NO 3-1271

PERMIT TO INSTALL SEPTIC TANK

Permit No. _____ Permit Date _____ 19__

Owner Sam Gaither Address _____

Installed By Sam Gaither Address _____


Location of Property Museum Sect. Lot #25 Kenmore Drive. Community water

Tank		Capacity		Length of Lines		Fixtures	
Block	( )	1000	( )	225'	( )	No. of Baths	(2)
Precast	(✓)	1250	( )	250'	( )	Dishwasher	( )
		1500	( )	Other 240'		Garbage Grdr.	( )
		Other				Other	

NOTIFY HEALTH DEPARTMENT AT LEAST EIGHT HOURS BEFORE TANK IS TO BE INSPECTED.

Final Inspection 7-25-1972 Approved (✓) Disapproved ( )

Remarks This tank installed without Health Dept. approval. Uncovered at request of Health Dept. Too close to property line.

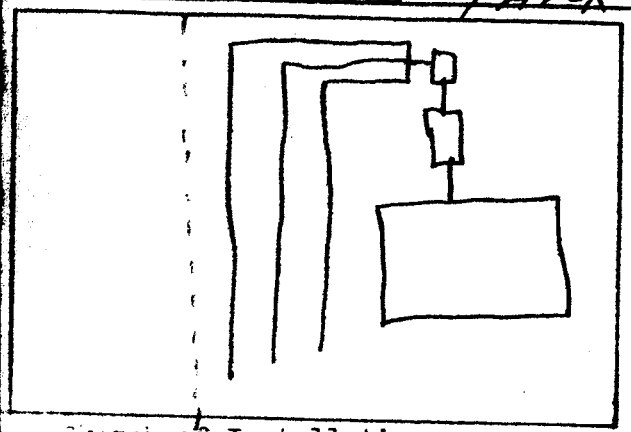

Sketch of Installation

Street

Glenn S. Hall

Sanitarian