IREDELL COUNTY HEALTH DEPARTMENT

Statesville Phone TR 3-7271 Mooresville Phone No. 664-5281

PERMIT TO INSTALL SEPTIC TANK

Permit No. 98 Permit Date 12-5 1972

Owner Gaither Bldr. Co. Address Statesville, NC.

Installed By Gaither Bld. Co. Address Statesville, NC

Location of Property Museum Rd - N. Kenmore Dr.


Lot #8

| Tank | | Capacity | | Length of Lines | | Fixtures | |
|---|---|---|---|---|---|---|---|
| Block | ( ) | 1000 | (✓) | 225' | ( ) | No. of Baths | (2) |
| Precast | (✓) | 1250 | ( ) | 250' | ( ) | Dishwasher | (1) |
| | | 1500 | ( ) | Other 275 | | Garbage Grdr. | ( ) |
| | | Other | | | | Other | |

NOTIFY HEALTH DEPARTMENT AT LEAST EIGHT HOURS BEFORE TANK IS TO BE INSPECTED.

Final Inspection 12-5 1972 Approved (✓) Disapproved ( )

Remarks Community WATER Supply

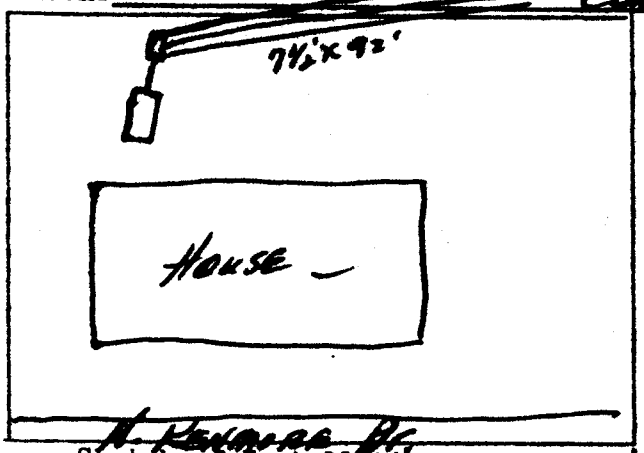


Sketch of Installation

Sanitarian