IREDELL COUNTY HEALTH DEPARTMENT

Statesville Phone TR 3-7271 Mooresville Phone NO 3-1271

PERMIT TO INSTALL SEPTIC TANK

Permit NO. _____ Permit Date Dec 17 1960

Owner JC Durant Belden. Address Chipley Ford Rd. RFD

Installed By [illegible] Address _____


Location of Property out Chipley Ford Rd past Lake Ecunk 1st new brick on Right - 1 mile out -

Tank	Capacity	Length of Lines	Fixtures
Block ( )	800 ( )	150' ( )	No. of Baths (2)
Precast (✓)	900 ( )	175' ( )	Dishwasher ( )
	1000 (✓)	200' ( )	Garbage Grdr. ( )
	1100 ( )	225' (✓)	Auto-Washer (✓)
	1200 ( )	250' ( )	Other _____
	Other _____	Other _____	

NOTIFY HEALTH DEPARTMENT AT LEAST EIGHT HOURS BEFORE TANK IS TO BE INSPECTED.

Final Inspection Dec 17 1960 Approved (✓) ~~Disapproved~~ ( )

Remarks Well 300 ft.

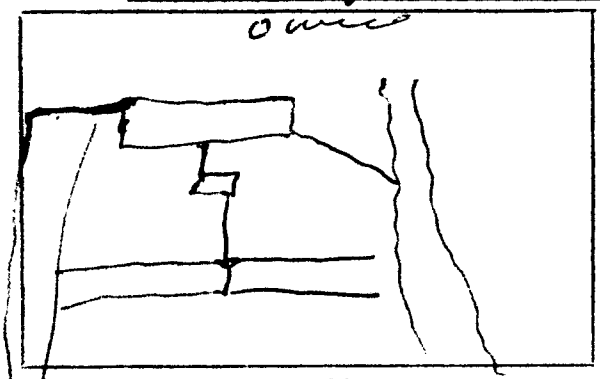

Sketch of Installation

Pat

Sanitarian