IREDELL COUNTY HEALTH DEPARTMENT

STATESVILLE 704-878-5305 CT MOORESVILLE 704-664-5281

IMPROVEMENT PERMIT / AUTHORIZATION TO CONSTRUCT / OPERATION PERMIT / EXISTING SYSTEM INSPECTION

PERMIT# 132827 PIN# 4735583064 DATE 1-9-05

OWNER OR CONTRACTOR Jill Kiernan PHONE: Business 704 562 6143 Home

ADDRESS 2020 Chipley Ford

LOCATION From I-40W, N on 115 (R) on Chipley Ford ~ 1 mile on right.

SUBDIVISION n/a BLOCK / SECTION n/a LOT LOT AREA 7.92 SITE CLASS. PS DESIGN FLOW 480 L.T.A.R. .3

Septic Tank: 1000 Gallons; STB 1012 Date 7-14-06
Pump Tank: Gallons; PT Date
Pump Make: Model Serial No.
Nitrification Field: No Fields 1 Square Feet 1600 Linear Feet 533
No Lines 4 Trench Width 3 Max Trench Bottom Depth 36 Gravel Depth n/a

☒ New System ☐ Repair System Type: I (II) III, IV, V, VI
System Description: Conventional Gravity
Repair System Description: Conventional Gravity
Maintenance Agreement Required: ☐ Yes ☒ No

☒ House/Mod. Home No. Bedrooms 4
☐ Mobile Home No. Bathrooms
☐ Business No. Employees
☐ Other


☐ Slab ☒ Crawl Space ☐ Basement w/plumbing ☐ Basement wo/plumbing

Water Supply: ☐ Individual ☒ Public ☐ Community

Comments:/Conditions: An approved system may also be used


1"=60'

INITIAL SITE SKETCH

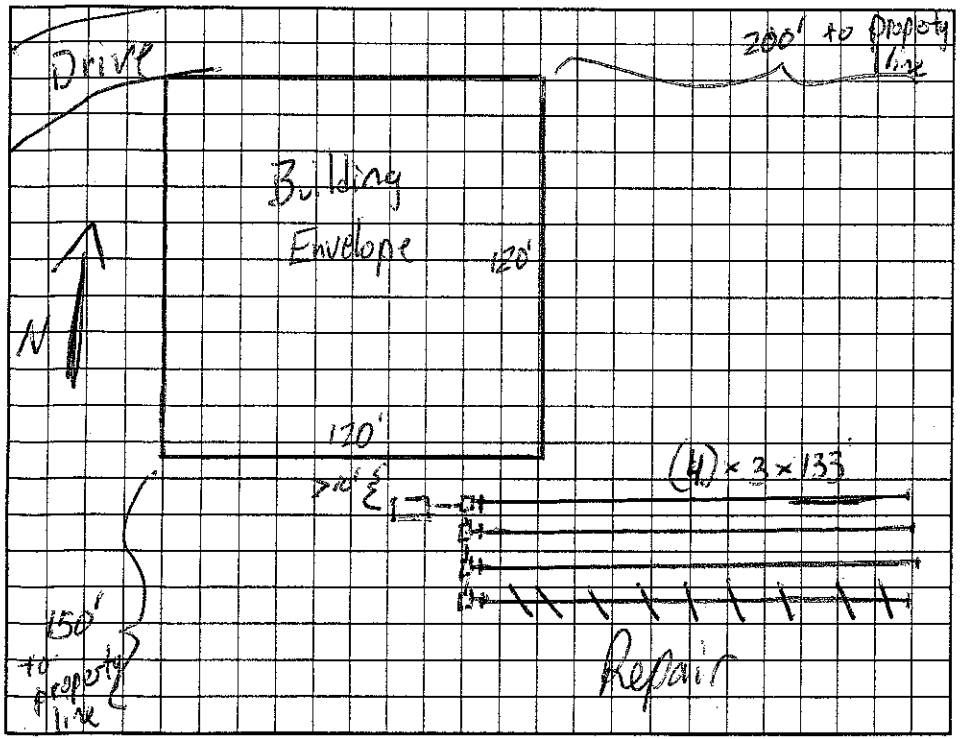

Comments:/Conditions: Yellow filter- ST marker / no risers

AS BUILT SKETCH

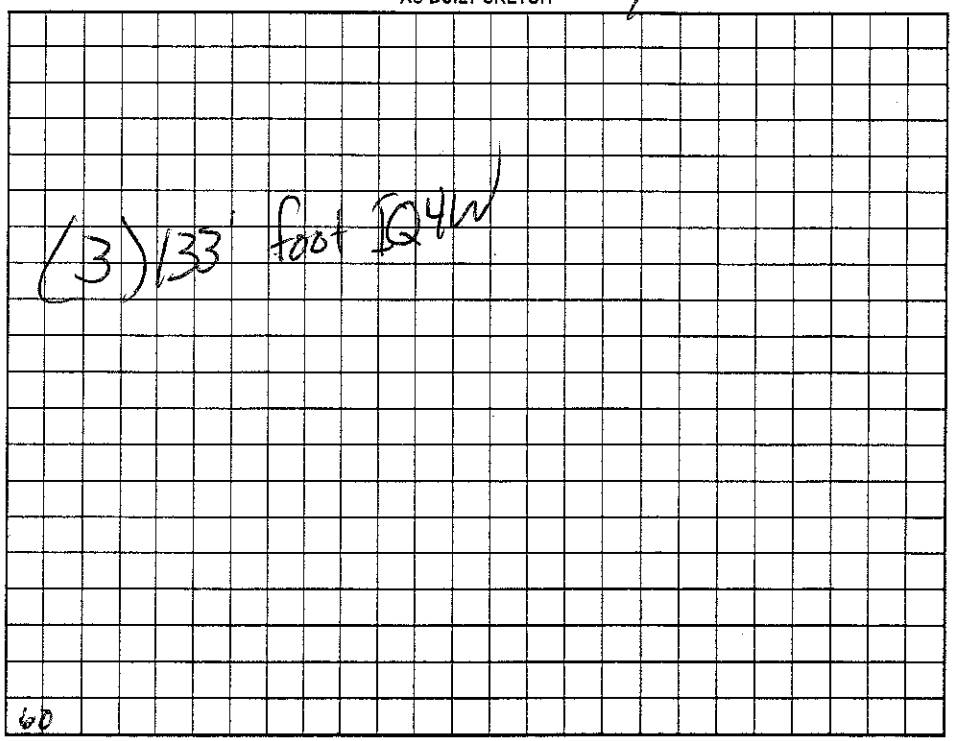

Permit can be suspended or revoked if any false information is supplied toward securing the permit/any unauthorized changes are made to the site/any unauthorized changes are made in the installation of the system. Improvement Permit with plat valid without expiration. Improvement Permit with site plan valid for sixty months. Authorization to Construct is valid for a period equal to that of Improvement Permit – not to exceed sixty months.

Signed: Deborah A. Gaddis date 3-9-06 Installed by: C&S Grading

Improvement Permit by: James date 1-9-06 Operation Permit by: James date 9-15-06

Authorization to Construct by: James date 1-9-06 Existing System Inspection by: date

HEALTH DEPT. COPY: WHITE OWNER COPY (FINAL): YELLOW OWNER COPY (INITIAL): PINK