IREDELL COUNTY HEALTH DEPARTMENT

STATESVILLE 704-878-5305 MOORESVILLE 704-664-5281

IMPROVEMENT PERMIT / CERTIFICATE OF COMPLETION / OPERATION PERMIT / EXISTING SYSTEM INSPECTION

PROPERTY DESCRIPTION NO. 068579 DATE 8-6-97 TAX MAP NO. 4735 59 4918 Watershed: ☐ Yes ☐ No

OWNER OR CONTRACTOR GERALD L. KALE PHONE: Business Home 873-0139

ADDRESS 309 S. GREENBRIAR ROAD, STATESVILLE, NC 28677

LOCATION US 21 N TL FORT DOBBS RD, TL S. CHIPLEY FORD 2ND LOT ON LEFT

SUBDIVISION DOBBS VIEW BLOCK / SECTION LOT 9 LOT AREA 0.988 ACRE SITE CLASS. PSI DESIGN FLOW 360 L.T.A.R. 0.30 GPD/FT²

Septic Tank: 1000 Gallons; ST# 1017 Date 9-15-97

Pump Tank: Gallons; PT Date

Pump Make: Model Serial No.

Nitrification Field: No Fields 1 Square Feet 1200 Linear Feet 400

No Lines FOUR Trench Width 36" Max Trench Bottom Depth 36" Gravel Depth 12"

☑ New System ☐ Repair System Type: I, II, III, IV, V, VI

System Description: CONVENTIONAL GRAVITY

Repair System Description: CHAMBERED GRAVITY

Maintenance Agreement Required: ☐ Yes ☑ No

☑ House/Mod. Home ☐ Mobile Home ☐ Business ☐ Other

No. Bedrooms 3 No. Bathrooms 2 No. Employees


☐ Slab ☑ Crawl Space ☐ Basement w/plumbing ☐ Basement wo/plumbing

Water Supply: ☐ Individual ☐ Community ☑ Public

Comments:

Comments:

INITIAL SITE SKETCH SCALE: 1" = 50'

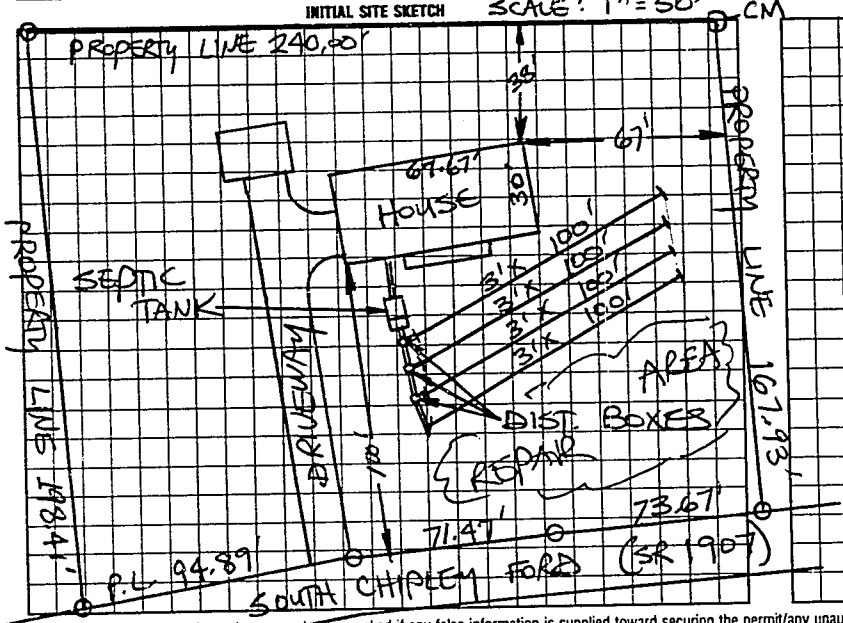

AS BUILT SKETCH

Installed as shown

I understand that this permit can be suspended or revoked if any false information is supplied toward securing the permit/any unauthorized changes are made to the site/any unauthorized changes are made in the installation of the system. Improvement Permit is valid for 60 months from date of issuance. AUTHORIZATION TO CONSTRUCT IS VALID FOR 60 MONTHS FROM DATE OF ISSUANCE.

Signed: + Gerald L. Kale Installed by: David Yount

Improvement Permit by: STEVE HEDRICK date 8-6-97

AUTH. TO CONST. ~~Existing System Inspection~~ by: STEVE HEDRICK date 8-6-97

~~Certificate of Completion~~ by: date

Operation Permit by: Mark C. Ort date 12-8-97

HEALTH DEPT. COPY: WHITE INSPECTION COPY (FINAL): GREEN OWNER COPY (FINAL): YELLOW INSPECTION COPY (INITIAL): PINK OWNER COPY (INITIAL): GOLD

8 9 1 0 0