IREDELL COUNTY HEALTH DEPARTMENT

Statesville Office (704) 878-5305 Mooresville Office (704) 660-3625 PERMIT # 212595

IMPROVEMENT PERMIT / AUTHORIZATION TO CONSTRUCT / OPERATION PERMIT / EXISTING SYSTEM

PIN # 4735596468

APPLICANT: Keith W. Sharpe APPLICANT ADDRESS: 2100 S. Chipley Ford Rd Statesville NC

SITE ADDRESS: 2100 S. Chipley Ford Rd Statesville NC PHONE: 704-233-3331 ALT. PHONE: 704-872-6271

SITE DIRECTIONS: 115 N T/R S. Chipley Ford Rd 1 mile on right

SUBDIVISION: N/A SECTION: N/A LOT # N/A LOT AREA: 8.28ac DESIGN FLOW: Ex L.T.A.R.: Ex

Septic Tank	Ex	(gal)	STB		Date				
Pump Tank		(gal)	PT		Date				
Pump Make			Model		Serial #				
# Nitrification Fields	Ex	# Lines	Ex	Linear Ft:	Ex				
Trench Width	Ex	Max. Trench Bottom Depth	Ex	Gravel Depth	Ex				

☐ New System ☐ Repair ☐ Expansion System Type: I ☒ II III IV V VI

System Description: Existing

Repair System Description:

Maintenance Agreement Required: ☐ YES ☒ NO

☑ GRAVITY ☐ PRESSURE

☒ Residence No. Bedrooms Ex

☐ Business No. Persons Ex

☐ Other No. Employees

☐ Slab ☐ Crawl Space


☐ Basement w/plumbing ☒ Basement w/o plumbing

Water Supply: ☒ Private ☒ Public ☐ Community

Comments / Conditions: All building foundations must be 55' from any part of STS and 525' from any well

INITIAL SITE SKETCH

AS BUILT SKETCH

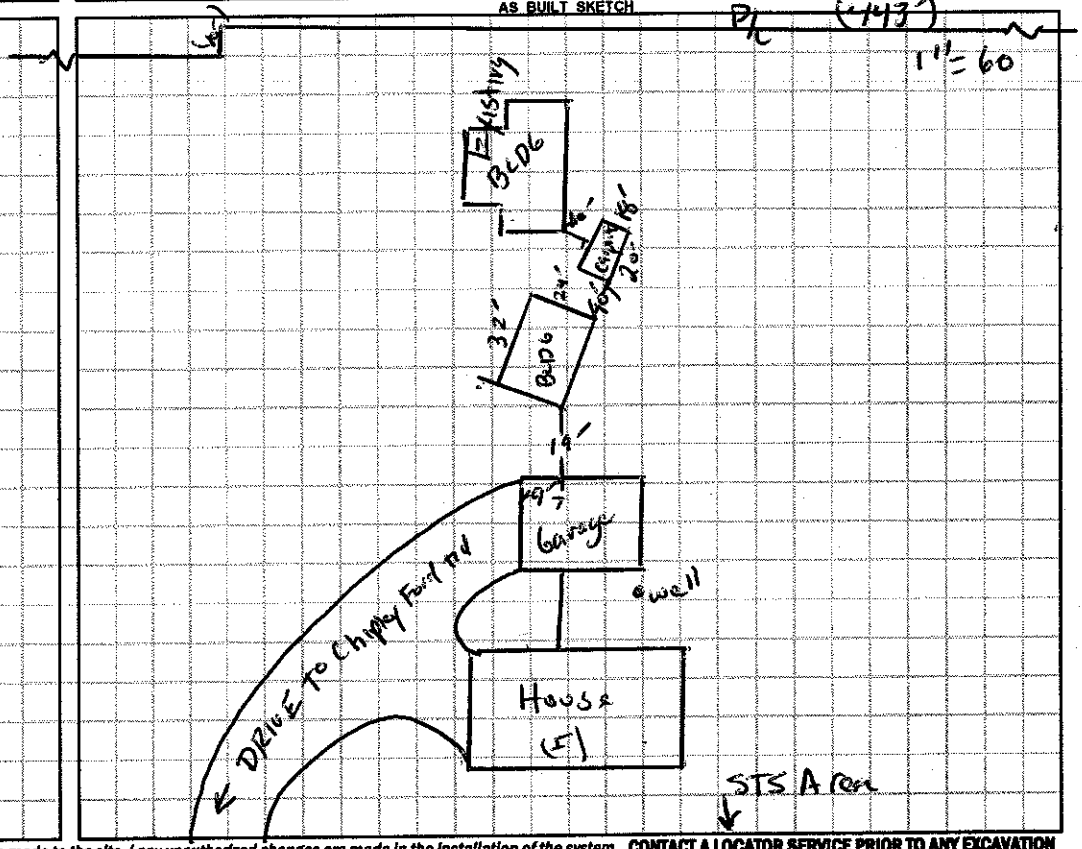

Permit can be suspended or revoked if any false information is supplied toward securing the permit / any unauthorized changes are made to the site / any unauthorized changes are made in the installation of the system. **CONTACT A LOCATOR SERVICE PRIOR TO ANY EXCAVATION**

☐ **IMPROVEMENT PERMIT** *with plat valid without expiration.* ☐ **IMPROVEMENT PERMIT** *with site plan valid for 60 mos.* ☐ **AUTHORIZATION TO CONSTRUCT** *valid for period equal to IMPROVEMENT PERMIT--not to exceed 60 mo.*

Owner / Applicant Signature: Keith W. Sharpe Date: 8-31-15 Installed by:

IMPROVEMENT PERMIT by: Date: OPERATION PERMIT by: Date:

AUTHORIZATION TO CONSTRUCT by: Date: Existing System Inspected by: Date: 08/25/15

Health Dept. Copy - WHITE Applicant (Final Approval) - YELLOW Applicant (Conditional Approval) - PINK