IREDELL COUNTY HEALTH DEPARTMENT

Statesville Phone TR 3-7271 Mooresville Phone NO 3-1271

PERMIT TO INSTALL SEPTIC TANK

Permit NO._____ Permit Date 10-8 1963

Owner SAM GAITHER Address STA

Installed By SELF Address


Location of Property ONT ARTS & SCIENCE MUSEUM RD PASS CREEK ROAD BEND 3RD BRICK ON LEFT

Tank		Capacity		Length of Lines		Fixtures	
Block	(X)	800	( )	150'	( )	No. of Baths	(1½)
Precast	( )	900	( )	175'	( )	Dishwasher	( )
		1000	(X)	200'	( )	Garbage Grdr.	( )
		1100	( )	225'	(X)	Auto-Washer	( )
		1200	( )	250'	( )	Other	
		Other		Other			

NOTIFY HEALTH DEPARTMENT AT LEAST EIGHT HOURS BEFORE TANK IS TO BE INSPECTED.

Final Inspection 10-8 1963 Approved (X) Disapproved ( )

Remarks SHOO BRICK

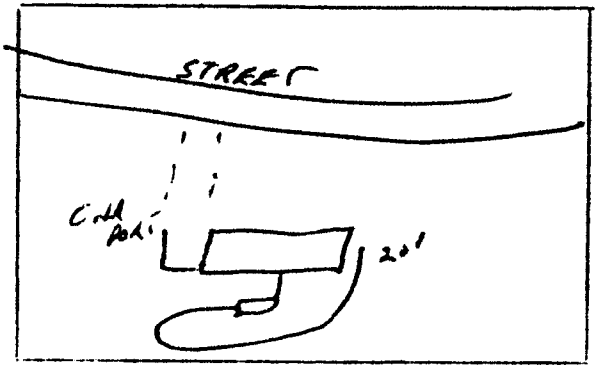

Sketch of Installation

Raymond G. Thomas, R.S.

Sanitarian