IREDELL COUNTY HEALTH DEPARTMENT

Statesville Phone TR 3-7271 Mooresville Phone NO 3-1271

PERMIT TO INSTALL SEPTIC TANK

Permit No. _____ Permit Date 7-30 1964

Owner SAM GAITHER (WILSON Address _____

Installed By // Address _____


Location of Property ON T POND SIA. RD. PASS MASONIC PASS 2ND STREET - 1st HOUSE ON LEFT

Tank		Capacity		Length of Lines		Fixtures	
Block	(✓)	1000	(✓)	225'	( )	No. of Baths	(1½)
Precast	( )	1250	( )	250'	( )	Dishwasher	( )
		1500	( )	Other _____		Garbage Grdr.	( )
		Other _____				Other _____	

NOTIFY HEALTH DEPARTMENT AT LEAST EIGHT HOURS BEFORE TANK IS TO BE INSPECTED.

Final Inspection 7-30 1964 Approved (✓) Disapproved ( )

Remarks _____

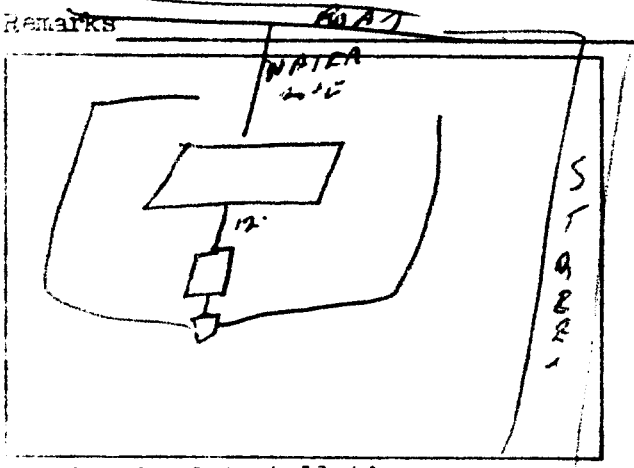

Sketch of Installation

Roland G. Thomas RS

Sanitarian