IREDELL COUNTY HEALTH DEPARTMENT

Statesville Phone TR 3-7271 Mooresville Phone NO 3-1271

PERMIT TO INSTALL SEPTIC TANK

Permit No. 146 Permit Date 9-15 1977

Owner Walther Bldg Co Address Statesville NC

Installed By Raymond Adams Address Haddenite NC

Location of Property

Kenmore Drive


Lot # 13

Tank		Capacity		Length of Lines		Fixtures	
Block	( )	1000	(✓)	225'	( )	No. of Baths	(2)
Precast	(✓)	1250	( )	250'	( )	Dishwasher	( )
		1500	( )	Other 240		Garbage Grdr.	( )
		Other				Other	

NOTIFY HEALTH DEPARTMENT AT LEAST EIGHT HOURS BEFORE TANK IS TO BE INSPECTED.

Final Inspection 9-15 1977 Approved (✓) Disapproved ( )

Remarks Community water

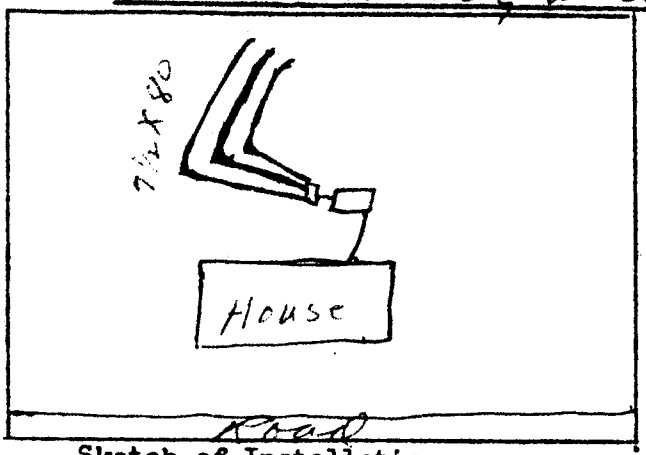

Sketch of Installation

E. G. Stevenson

Sanitarian