IREDELL COUNTY HEALTH DEPARTMENT

Statesville Phone TR 3-7271 Mooresville Phone NO 3-1271

PERMIT TO INSTALL SEPTIC TANK

Permit No. 146 Permit Date 9-15 19--

Owner Walther Bldg Co Address Statesville N.C.

Installed By Raymond Adams Address Hiddenite N.C.

Location of Property Kenmore Drive -


Lot # 12

| Tank | | Capacity | | Length of Lines | | Fixtures | |
|---|---|---|---|---|---|---|---|
| Block | ( ) | 1000 | (✓) | 225' | ( ) | No. of Baths | (2) |
| Precast | (✓) | 1250 | ( ) | 250' | ( ) | Dishwasher | (✓) |
| | | 1500 | ( ) | Other 240 | | Garbage Grdr. | ( ) |
| | | Other | | | | Other | |

NOTIFY HEALTH DEPARTMENT AT LEAST EIGHT HOURS BEFORE TANK IS TO BE INSPECTED.

Final Inspection 9-15 1972 Approved (✓) Disapproved ( )

Remarks Community Water

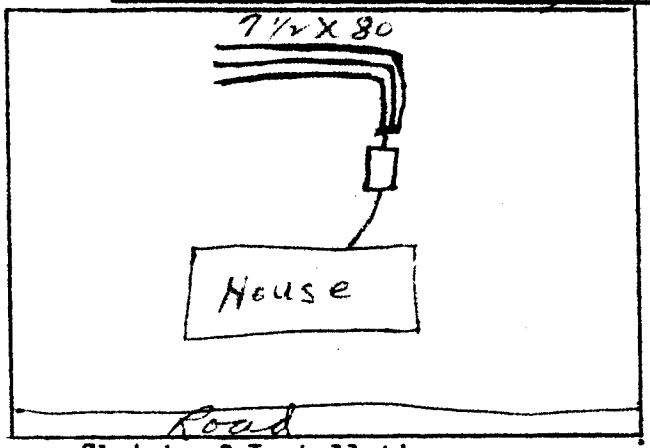


Sketch of Installation

E. G. Stevenson

Sanitarian