IREDELL COUNTY HEALTH DEPARTMENT

Statesville Phone TR 3-7271 Mooresville Phone NO 3-1271

PERMIT TO INSTALL SEPTIC TANK

Permit No. 146 Permit Date 9-15 19 72

Owner Smithey Bldg Co Address Statesville, NC

Installed By Raymond Adams Address Haddenville, NC

Location of Property

Kenmore Drive


Lot # 11

Tank		Capacity		Length of Lines		Fixtures	
Block	( )	1000	( )	225'	( )	No. of Baths	(2)
Precast	(✓)	1250	(✓)	250'	( )	Dishwasher	(✓)
		1500	( )	Other 260'		Garbage Grdr.	(✓)
		Other				Other	

NOTIFY HEALTH DEPARTMENT AT LEAST EIGHT HOURS BEFORE TANK IS TO BE INSPECTED.

Final Inspection 9-15 19 72 Approved (✓) Disapproved ( )

Remarks Well 100' from Tank

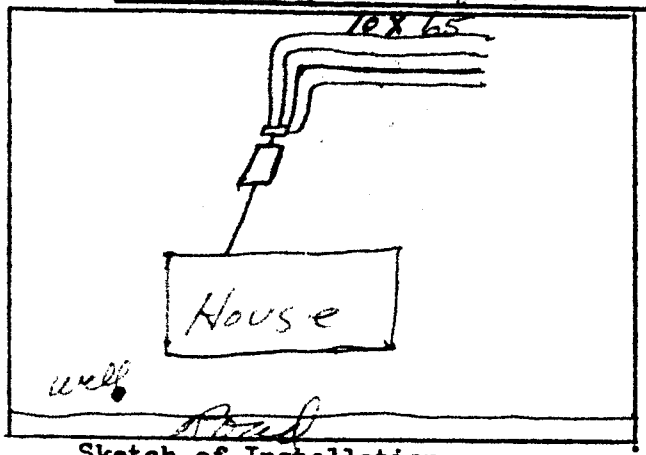

Sketch of Installation

E. A. Stevenson

Sanitarian