IREDELL COUNTY HEALTH DEPARTMENT

STATESVILLE 704-878-5305 MOORESVILLE 704-664-5281

IMPROVEMENT PERMIT / CERTIFICATE OF COMPLETION / OPERATION PERMIT / EXISTING SYSTEM INSPECTION

PROPERTY DESCRIPTION NO. 66152 DATE 5-27-97 TAX MAP NO. 4735-69-0972 Watershed: ☐ Yes ☐ No

OWNER OR CONTRACTOR Edwin Hunter Homes PHONE: Business 873 0568 Home

ADDRESS 1602 Davie Avenue Sta.

LOCATION Chipley Ford TR. Fort Dobbs Rd. 6th lot Rt

SUBDIVISION Dobbsview BLOCK / SECTION LOT 2 LOT AREA .73 acres SITE CLASS. PS DESIGN FLOW 360 L.T.A.R. 133

Septic Tank: 1000 Gallons; STB 1794 Date 10-7-97

Pump Tank: Gallons; PT Date

Pump Make: Model Serial No.

Nitrification Field: No Fields 1 Square Feet 1080 Linear Feet 360

No Lines 3 Trench Width 36" Max Trench Bottom Depth 36" Gravel Depth 12"

☑ New System ☐ Repair System Type: I, II, III, IV, V, VI

System Description: Conv. Gravity

Repair System Description: Pump to Chambers

Maintenance Agreement Required: ☐ Yes ☑ No

☑ House/Mod. Home No. Bedrooms 3

☐ Mobile Home No. Bathrooms 3

☐ Business No. Employees

☐ Other


☐ Slab ☑ Crawl Space ☐ Basement w/plumbing ☐ Basement wo/plumbing

Water Supply: ☐ Individual ☐ Community ☑ Public


Comments:

Comments:

INITIAL SITE SKETCH

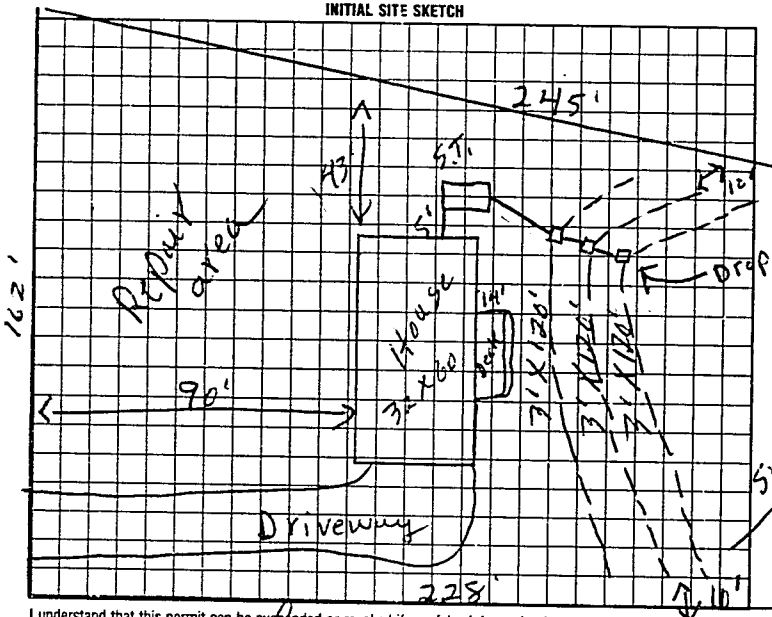

AS BUILT SKETCH

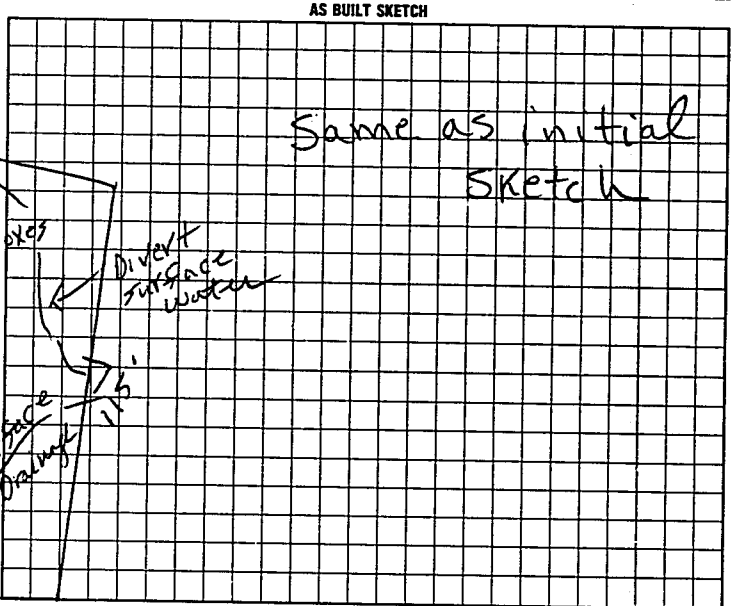

I understand that this permit can be suspended or revoked if any false information is supplied toward securing the permit/any unauthorized changes are made to the site/any unauthorized changes are made in the installation of the system. Improvement Permit is valid for 60 months from date of issuance.

Signed: X

Improvement Permit by: P.C. moore date 5-24-97

Authorization to Existing System Inspection by: P.C. moore date 5-24-97

Installed by: Atlantic Excavating (Dan Baker)

Certificate of Completion by: date

Operation Permit by: P.C. moore date 11-12-97

HEALTH DEPT COPY WHITE INSPECTION COPY (FINAL) GREEN OWNER COPY (FINAL) YELLOW INSPECTION COPY (INITIAL) PINK OWNER COPY (INITIAL) GOLD

to count.

Authorization to count. Expires 60 mos from issue

5 2 6 1 0 0