IREDELL COUNTY HEALTH DEPARTMENT

STATESVILLE 704-878-5305 MOORESVILLE 704-664-5281

IMPROVEMENT PERMIT / AUTHORIZATION TO CONSTRUCT / OPERATION PERMIT / EXISTING SYSTEM INSPECTION

PERMIT# REPAIR PIN# 4735-72-7058 DATE 11-3-06

OWNER OR APPLICANT CITY of STATESVILLE, McCLURE PARK PHONE: Business 704-878-3429 Home

ADDRESS P.O. BOX 1111 STATESVILLE NC 28687

LOCATION NC 115 N, TR S. CHIPLEY FORD, TR MUSEUM ROAD, BALLPARK ON LEFT PAST GREGORY CREEK

SUBDIVISION BLOCK / SECTION LOT LOT AREA 15.08 ACRES SITE CLASS. PS DESIGN FLOW 750 L.T.A.R. 0.30 GAD/FT²

ADDITIONAL

Septic Tank: 1000 Gallons: STB 1012 Date 4-19-06

Pump Tank: Gallons: PT Date

Pump Make: Model Serial No.

Nitrification Field: No Fields 1 Square Feet 2500 Linear Feet 625

No Lines FIVE Trench Width 36" Max Trench Bottom Depth 36" Gravel Depth N/A

☐ New System ☑ Repair ☐ Expansion System Type: I II (III) IV V VI

System Description:

Repair System Description: 25% REDUCTION, GRAVITY

Maintenance Agreement Required: ☐ Yes ☑ No

☐ House/Mod. Home No. Bedrooms

☐ Mobile Home

☐ Business No. Persons

☐ Other PARK W/ 250 PERSONS MAX No. Employees

Water Supply: ☐ Individual ☑ Public ☐ Community


☑ Gravity ☐ Pressure ☑ Slab ☐ Crawl Space ☐ Basement w/plumbing ☐ Basement wo/plumbing

Comments:/Conditions: ABANDON EXISTING DRAINFIELD, INSTALL NEW SEPTIC TANK IN SERIES WITH EXISTING TANK, INSTALL NEW 25% REDUCTION SYSTEM ON CONTOUR AS SHOWN. CONTACT HEALTH DEPT. TO FLAG-OUT SYSTEM AFTER CLEARING.


Comments:/Conditions:

PROPERTY LINE 1287'

INITIAL SITE SKETCH

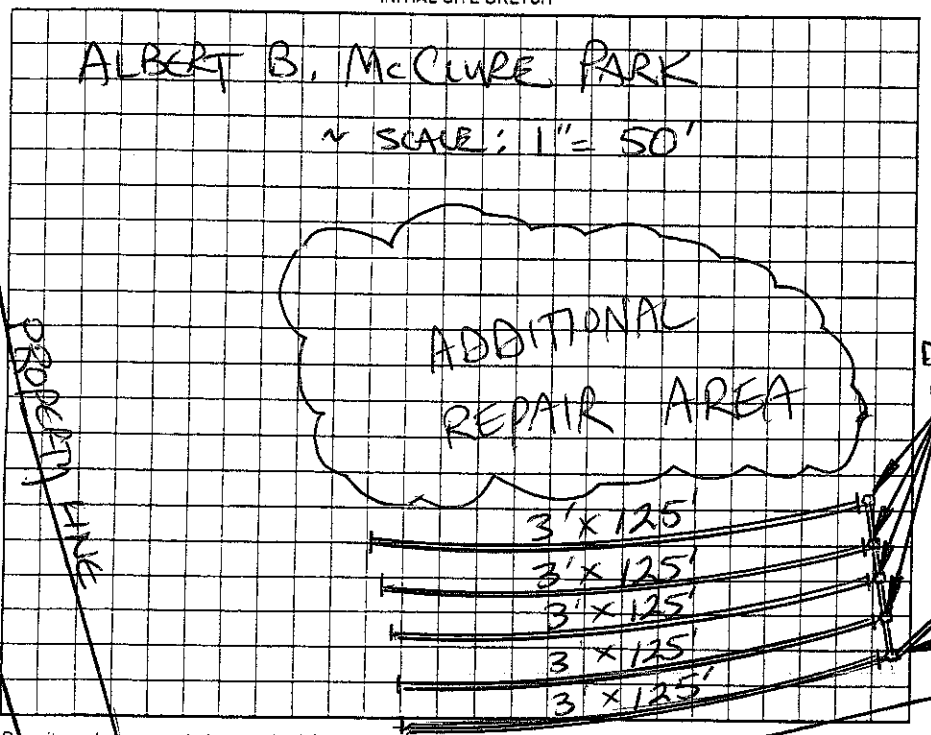

AS BUILT SKETCH

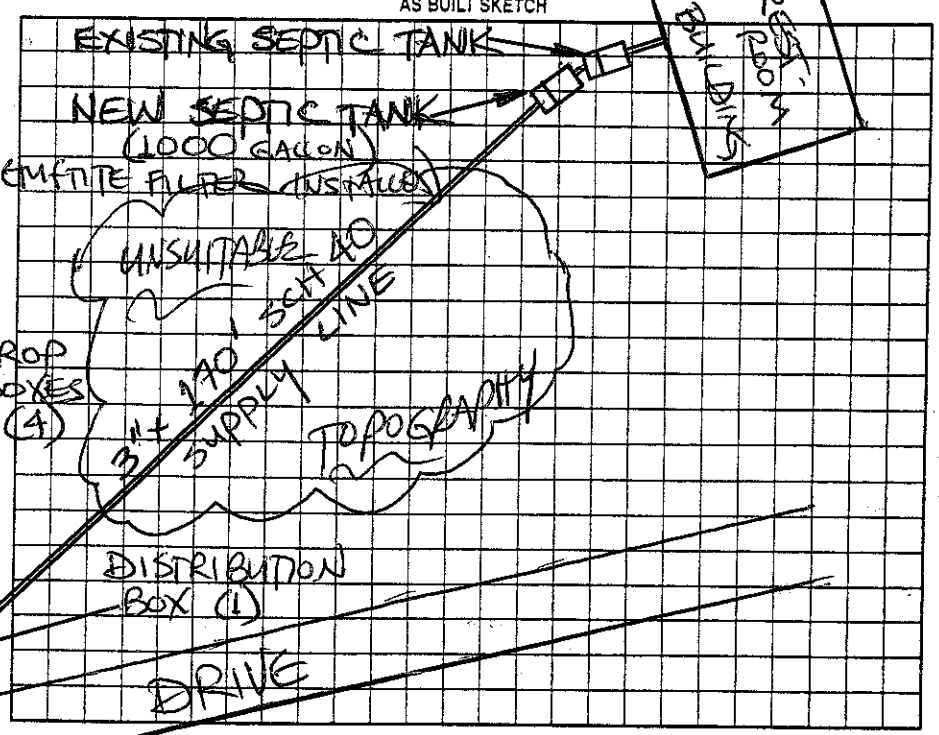

Permit can be suspended or revoked if any false information is supplied toward securing the permit/any unauthorized changes are made to the site/any unauthorized changes are made in the installation of the system. Improvement Permit with plat valid without expiration ☐ Improvement Permit with site plan valid for sixty months ☑ Authorization to Construct is valid for a period equal to that of Improvement Permit – not to exceed sixty months.

Signed: date 11/16/06 Installed by: PIEDMONT BACKHOE

Improvement Permit by: STEVE HEDRICK date 11-3-06 Operation Permit by: STEVE HEDRICK date 12-13-06

Authorization to Construct by: STEVE HEDRICK date 11-3-06 Existing System Inspection by: date

HEALTH DEPT. COPY: WHITE OWNER COPY (FINAL): YELLOW OWNER COPY (INITIAL): PINK