IREDELL COUNTY HEALTH DEPARTMENT - *ENVIRONMENTAL HEALTH* ☑ STATESVILLE OFFICE 704-878-5305 ☐ MOORESVILLE OFFICE 704-664-5281

IMPROVEMENT PERMIT / AUTHORIZATION TO CONSTRUCT / OPERATION PERMIT / EXISTING SYSTEM INSPECTION

PERMIT # 171414 PIN # 4735-79-4546 DATE MARCH 16, 2012

OWNER FORT DOBBS STATE of NC APPLICANT: SAME PHONE: Home/Cell # 704-902-0948 Business # 704-873-5882

SITE ADDRESS 438 FORT DOBBS ROAD OWNER / APPLICANT ADDRESS 438 FORT DOBBS RD, STATESVILLE, NC 28625

SITE DIRECTIONS US 21 NORTH, TL FORT DOBBS ROAD, 1.6 MILES ON RIGHT

SUBDIVISION N/A BLOCK / SECTION N/A LOT # N/A LOT AREA 32.66 Ac DESIGN FLOW ~600 GPD L.T.A.R. EXISTING 0.4

Septic Tank EXISTING Gallons: STB ____ Date ____

Pump Tank ____ Gallons: P T ____ Date ____

Pump Make ____ Model ____ Serial # ____

No. Nitrification Fields: 1 No. Lines 5 Linear Feet EX: 500'

Trench Width EX: 36" Max. Trench Bottom Depth ____ Gravel Depth ____

☑ New System ☐ Repair ☐ Expansion System Type I II (III) V V VI

System Description: CONVENTIONAL, GRAVITY, UPGRADE

Repair System Description: CONVENTIONAL, GRAVITY

Maintenance Agreement Required ☐ YES ☑ NO

☑ GRAVITY ☐ PRESSURE

☐ Residence No. Bedrooms ____

☐ Business No. Persons ____

☑ Other HISTORICAL SITE No. Employees ____

☑ Slab TOILET FACILITIES ☐ Crawl Area


☐ Basement w/plumbing ☐ Basement w/o plumbing

Water Supply: ☐ Private ☑ Public ☐ Community

Comments / Conditions:

1. PUMP-OUT CONTENTS of EXISTING SEPTIC TANK.
2. INSTALL RISERS TO GROUND SURFACE OVER BOTH ACCESS OPENINGS.
3. INSTALL NEW SANITARY TEE WITH EFFLUENT SPLITTER.
4. INSTALL NEW EFFLUENT SPLITTER for PARALLEL DISTRIBUTION.

INITIAL SITE SKETCH

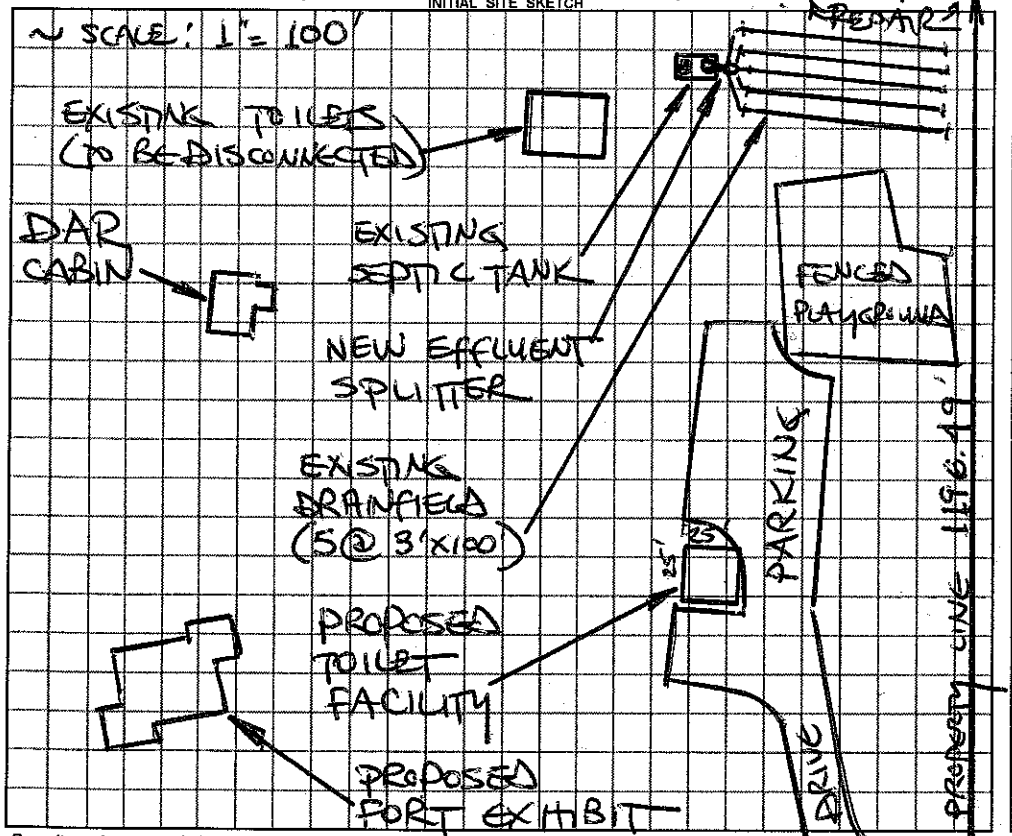

AS BUILT SKETCH

SYSTEM INSTALLED ACCORDING TO INITIAL SITE SKETCH, DISTRIBUTION BOX SUBSTITUTED FOR EFFLUENT SPLITTER DUE TO ROOT GROWTH & PLAN FOR FUTURE MAINTENANCE

ROAD

Permit can be suspended or revoked if any false information is supplied toward securing the permit / any unauthorized changes are made to the site / any unauthorized changes are made in the installation of the system.

☐ ***IMPROVEMENT PERMIT*** with plat valid without expiration. ☑ ***IMPROVEMENT PERMIT*** with plat valid without expiration. Site plan valid 60 mo. ☑ ***AUTHORIZATION TO CONSTRUCT*** valid for period equal to IMPROVEMENT PERMIT--not to exceed 60 mo.

Owner / Applicant Signature: Mark Lentz Date 3/19/12 Installed by: JARRID LENTZ

IMPROVEMENT PERMIT by: R. STEVE HEDRICK REHS Date 3-16-12 OPERATION PERMIT by: STEVE HEDRICK REHS Date 4-12-12

AUTHORIZATION TO CONSTRUCT by: R. STEVE HEDRICK REHS Date 3-16-12 Existing System Inspected by: ____ REHS Date ____

YOU SHOULD CONTACT A LOCATOR SERVICE PRIOR TO ANY EXCAVATION

White Copy -- Environmental Health YELLOW COPY (Final) Owner / Applicant PINK COPY (Initial) Owner / Applicant