IREDELL COUNTY HEALTH DEPARTMENT

Statesville Office (704) 878-5305 Mooresville Office (704) 660-3625 PERMIT # 179005

IMPROVEMENT PERMIT / AUTHORIZATION TO CONSTRUCT / OPERATION PERMIT / EXISTING SYSTEM

PIN # 4735814811

APPLICANT: Joseph Raymond APPLICANT ADDRESS: 401 Coolidge Ave

SITE ADDRESS: 401 Coolidge Ave PHONE: 704-657-4642 ALT. PHONE: N/A

SITE DIRECTIONS: Hwy 115 N TR Hartness Rd TL Lakewood Dr TR Coolidge Ave 1st lot on left

SUBDIVISION: Clear View Development SECTION: N/A LOT # 65 LOT AREA: .57 acres DESIGN FLOW: 360gpd L.T.A.R.: Existing

Septic Tank	Existing	(gal)	STB		Date						
Pump Tank		(gal)	PT		Date						
Pump Make			Model		Serial #						
# Nitrification Fields	Ex	# Lines	Ex	Linear Ft:	Ex						
Trench Width	Ex	Max. Trench Bottom Depth	Ex	Gravel Depth	Ex						

☐ New System ☐ Repair ☐ Expansion System Type: I (II) III IV V VI

System Description: Conventional

Repair System Description:

Maintenance Agreement Required: ☐ YES ☑ NO

☑ GRAVITY ☐ PRESSURE

☑ Residence No. Bedrooms 3

☐ Business No. Persons

☐ Other No. Employees

☐ Slab ☑ Crawl Space

☐ Basement w/plumbing ☐ Basement w/o plumbing

Water Supply

☐ Private

☑ Public


☐ Community

Comments / Conditions:

Pool is a minimum of 15' From all Components of septic tank system.

INITIAL SITE SKETCH

AS BUILT SKETCH

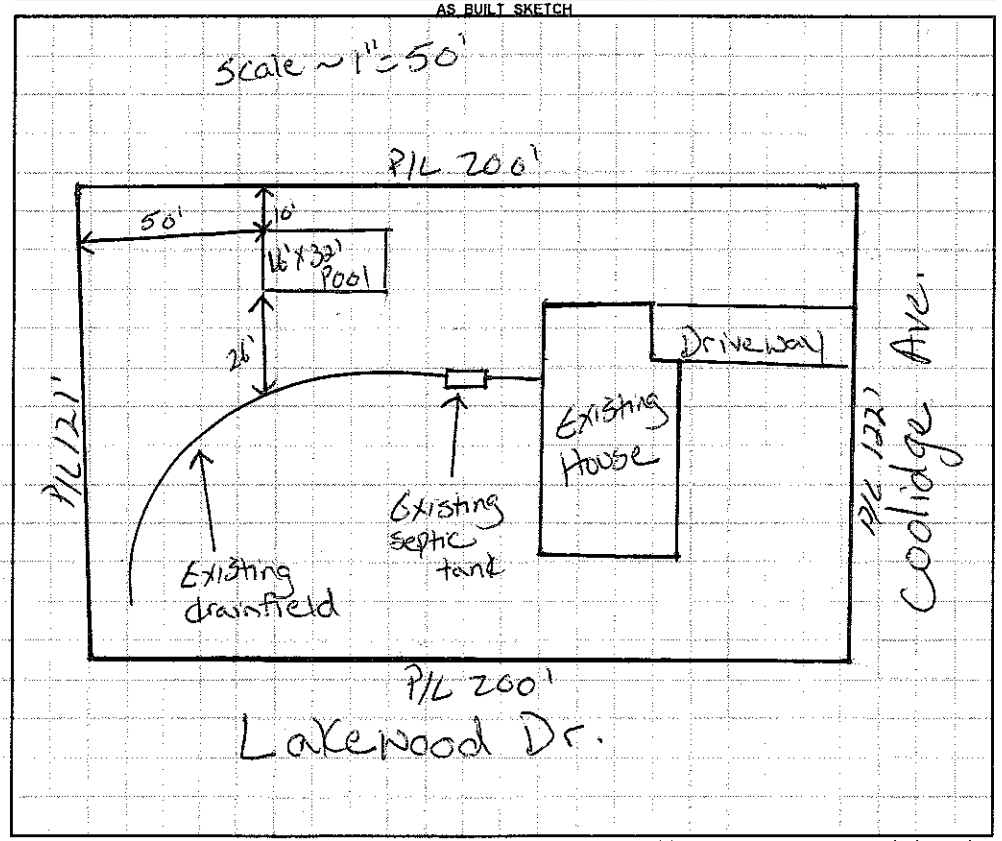

Permit can be suspended or revoked if any false information is supplied toward securing the permit / any unauthorized changes are made to the site / any unauthorized changes are made in the installation of the system. **CONTACT A LOCATOR SERVICE PRIOR TO ANY EXCAVATION**

☐ **IMPROVEMENT PERMIT** *with plat valid without expiration.* ☐ **IMPROVEMENT PERMIT** *with site plan valid for 60 mos.* ☐ **AUTHORIZATION TO CONSTRUCT** *valid for period equal to IMPROVEMENT PERMIT--not to exceed 60 mo.*

Owner / Applicant Signature: Candice A Raymond Date: 6-12-13 Installed by:

IMPROVEMENT PERMIT by: Date: OPERATION PERMIT by: Date:

AUTHORIZATION TO CONSTRUCT by: Date: Existing System Inspected by: Justin Henderson Date: 6-3-13

Health Dept. Copy - WHITE Applicant (Final Approval) - YELLOW Applicant (Conditional Approval) - PINK