IREDELL COUNTY HEALTH DEPARTMENT

Statesville Phone TR 3-7271 Mooresville Phone NO 3-1271

PERMIT TO INSTALL SEPTIC TANK

Permit NO. _____ Permit Date AUG 27 1959

Owner SAM GAITHER (BUILDER) Address STATESVILLE, N.C.

Installed By " Address _____


Location of Property VA AVE. JUST BEHIND GAITHER BUILDING CO.

Tank		Capacity		Length of Lines		Fixtures	
Block	(✓)	800	( )	150'	( )	No. of Baths	(1)
Precast	( )	900	( )	175'	( )	Dishwasher	( )
		1000	(✓)+	200'	(✓)+	Garbage Grdr.	( )
		1100	( )	225'	( )	Auto-Washer	(1)
		1200	( )	250'	( )	Other	_____
		Other	_____	Other	_____		

NOTIFY HEALTH DEPARTMENT AT LEAST EIGHT HOURS BEFORE TANK IS TO BE INSPECTED.

Final Inspection AUG 27 1959 Approved (✓) Disapproved ( )

Remarks _____

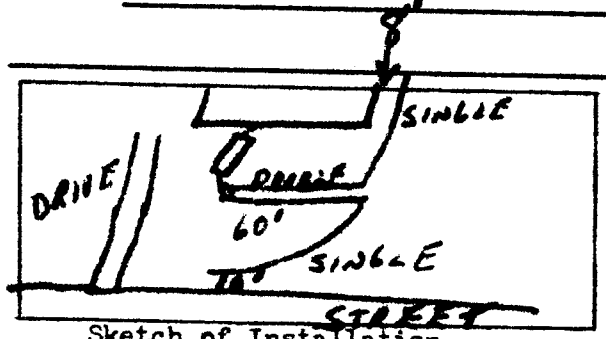

Sketch of Installation

Robert A. Johnson

Sanitarian