2-7

IREDELL COUNTY HEALTH DEPARTMENT

Statesville Phone TR 3-7271 Mooresville Phone NO 3-1271

PERMIT TO INSTALL SEPTIC TANK

Permit No. Ken Lippard Bldr. Permit Date July 17 1969

Owner Mick Duke Address C/O WDBM Radio

Installed By C Hoke & Sons Address R7


Location of Property Radio WDBM Sta.

Tank		Capacity		Length of Lines		Fixtures	
Block	( )	1000	( )	225'	( )	No. of Baths	(4)
Precast	(✓)	1250	(4)	250'	( )	Dishwasher	(4)
Leach		1500	( )	Other 285		Garbage Grdr.	(4)
		Other				Other	

NOTIFY HEALTH DEPARTMENT AT LEAST EIGHT HOURS BEFORE TANK IS TO BE INSPECTED.

Final Inspection 19 Approved (✓) Disapproved ( )

Remarks city wata. tight soil

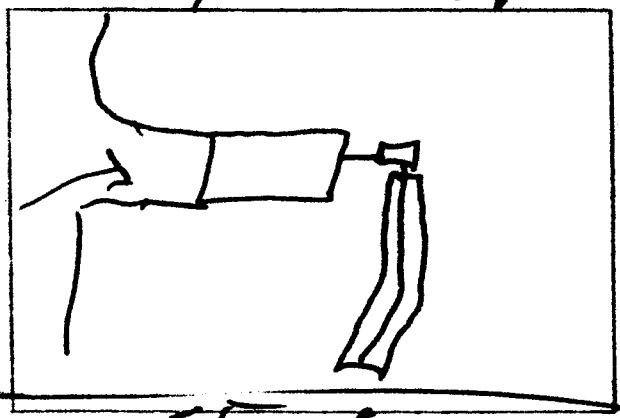

Sketch of Installation

Sanitarian