2114

IREDELL COUNTY HEALTH DEPARTMENT

Statesville Phone TR 3-7271 Mooresville Phone NO 3-1271

PERMIT TO INSTALL SEPTIC TANK

Permit NO._____ Permit Date_____ 195__

Owner Richardson Address_____

Installed By Leon Smith Address_____

Location of Property Willard Drive


Lot No. 12

Tank		Capacity		Length of Lines		Fixtures	
Block	(X)	800	( )	150'	( )	No. of Baths	(1)
Precast	( )	900	( )	175'	( )	Dishwasher	( )
		1000	( )	200'	( )	Garbage Grdr.	( )
		1100	( )	225'	(X)	Auto-Washer	(X)
		1200	( )	250'	( )	Other_____	
		Other 1800		Other_____			

NOTIFY HEALTH DEPARTMENT AT LEAST EIGHT HOURS BEFORE TANK IS TO BE INSPECTED.

Final Inspection Dec 1 195[illegible] Approved (X) Disapproved ( )

Remarks_____

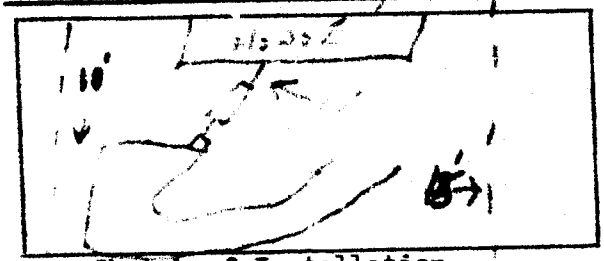

Sketch of Installation

Robert A Thomas

Sanitarian