IREDELL COUNTY HEALTH DEPARTMENT

Statesville Phone TR 3-7271 Mooresville Phone NO 3-1271

PERMIT TO INSTALL SEPTIC TANK

Permit NO. _____ Permit Date SEPT 10, 1958

Owner SAM GAITHER Address STATESVILLE, N.C.

Installed By GAITHER Address _____

Location of Property ON PUMP STATION ROAD - LEFT ON HILLCREST RD. 1ST HOUSE ON LEFT


Tank		Capacity		Length of Lines		Fixtures	
Block	(✓)	800	( )	150'	( )	No. of Baths	(1)
Precast	( )	900	(✓)	175'	( )	Dishwasher	( )
		1000	( )	200'	( )	Garbage Grdr.	( )
		1100	( )	225'	(✓)	Auto-Washer	( )
		1200	( )	250'	( )	Other	_____
		Other	_____	Other	_____		

NOTIFY HEALTH DEPARTMENT AT LEAST EIGHT HOURS BEFORE TANK IS TO BE INSPECTED.

Final Inspection SEPT 11, 1958 Approved (✓) Disapproved ( )

Remarks _____

LINES PITTED

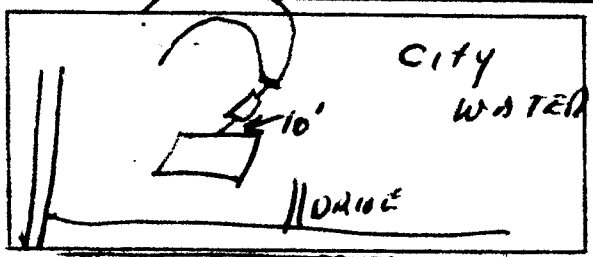

Sketch of Installation

Rufus A. Holmes

Sanitarian