IREDELL COUNTY HEALTH DEPARTMENT

Statesville Phone TR 3-7271 — Mooresville Phone NO 3-1271

PERMIT TO INSTALL SEPTIC TANK

Permit NO. _____ Permit Date APRIL 7 1959

Owner GAITHER BLDG CO. Address STATESVILLE, N.C

Installed By " Address "


Location of Property ACCROSS THE ROAD FROM W. S. I. C. PINK SIDING HOUSE.

Tank		Capacity		Length of Lines		Fixtures	
Block	(✓)	800	( )	150'	( )	No. of Baths	(1)
Precast	( )	900	( )	175'	( )	Dishwasher	(1)
		1000	(✓)	200'	( )	Garbage Grdr.	( )
		1100	( )	225'	(✓)	Auto-Washer	( )
		1200	( )	250'	( )	Other _____	
		Other _____		Other _____			

NOTIFY HEALTH DEPARTMENT AT LEAST EIGHT HOURS BEFORE TANK IS TO BE INSPECTED.

Final Inspection APRIL 9 1959 Approved (✓) Disapproved ( )

Remarks _____

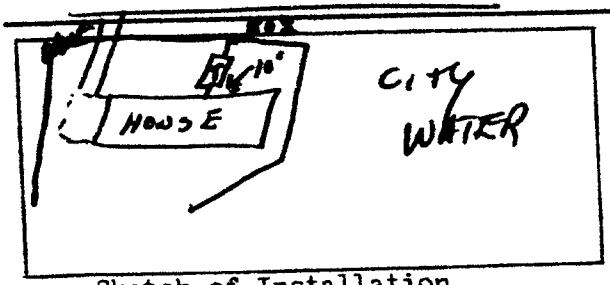

Sketch of Installation

Rufford A. Horne

Sanitarian